


T. 23 S. R. 30 E. W. M.

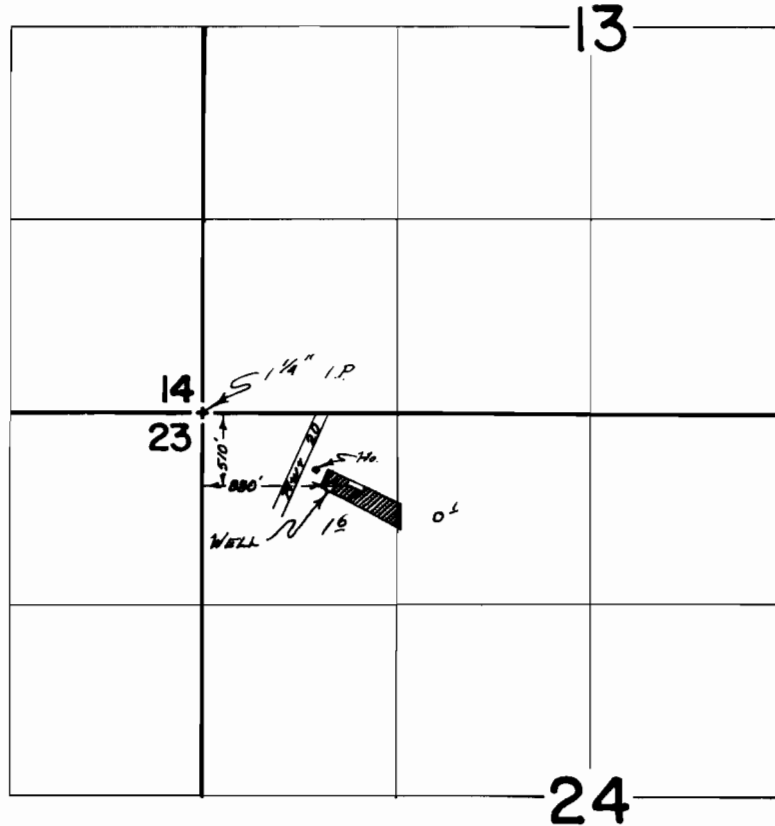

FINAL PROOF SURVEY
UNDER

Application No. Q-3893 Permit No. Q-7652
IN NAME OF

JOE O. & BETTY J. ENNEBERG

Surveyed Aug. 28, 1972, by R. G. MURKIN