


T. 23 S. R. 30 E. W. M. .

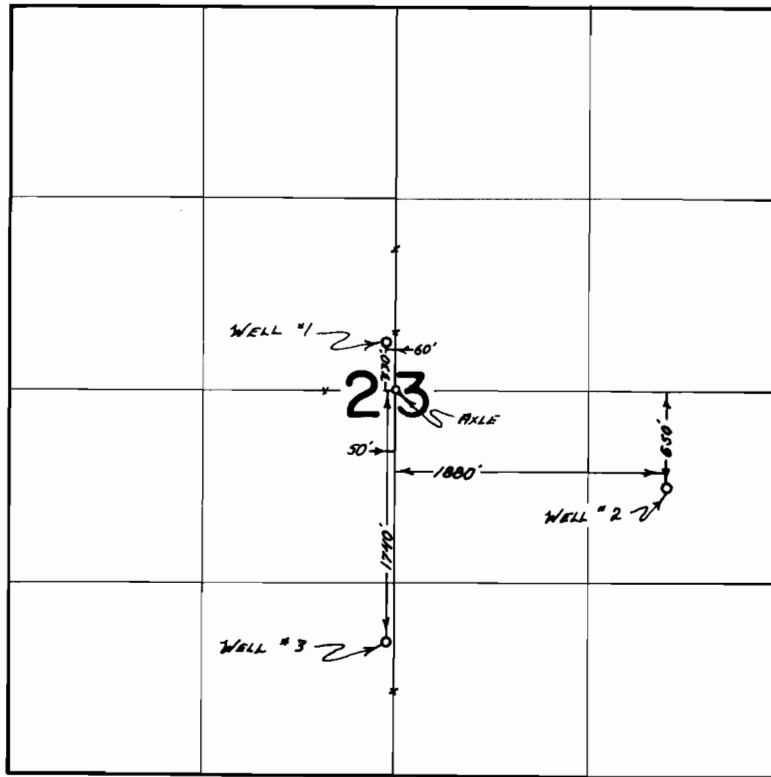

**FINAL PROOF SURVEY**  
UNDER

Application No. A-3872 Permit No. A-3827  
IN NAME OF

CITY OF HINES

Surveyed Aug. 28 1972, by R.G. MURPHY