


T. 23 S. R. 30 & 31 E. W.M.

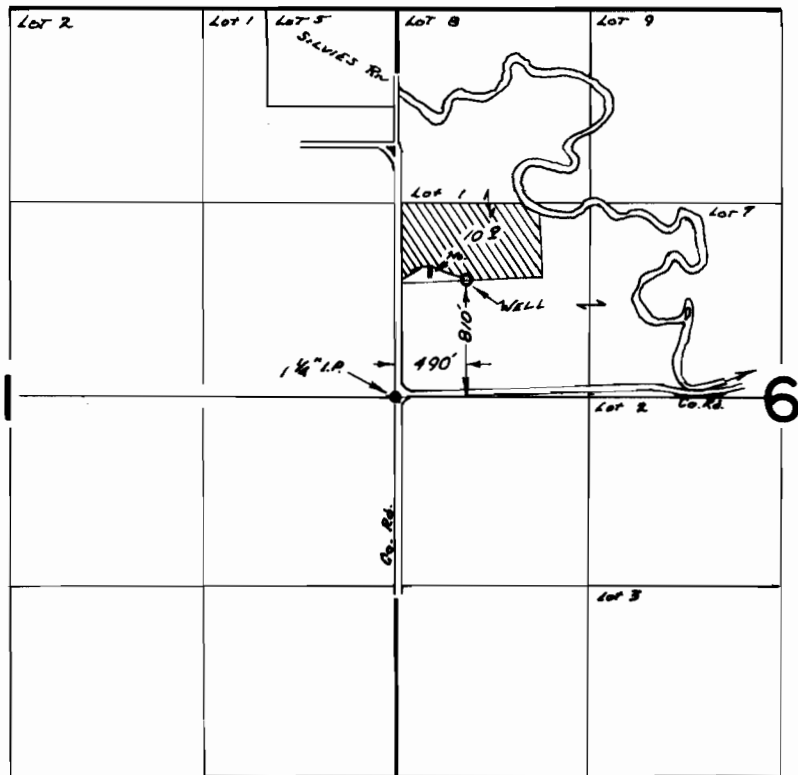

FINAL PROOF SURVEY
UNDER

Application No. G-4396 Permit No. G-4144
IN NAME OF

KENNETH W. RETHERFORD

Surveyed Aug. 22 1972, by R. G. MURKIN