


T. 23 S. R. 27 E. W. M.

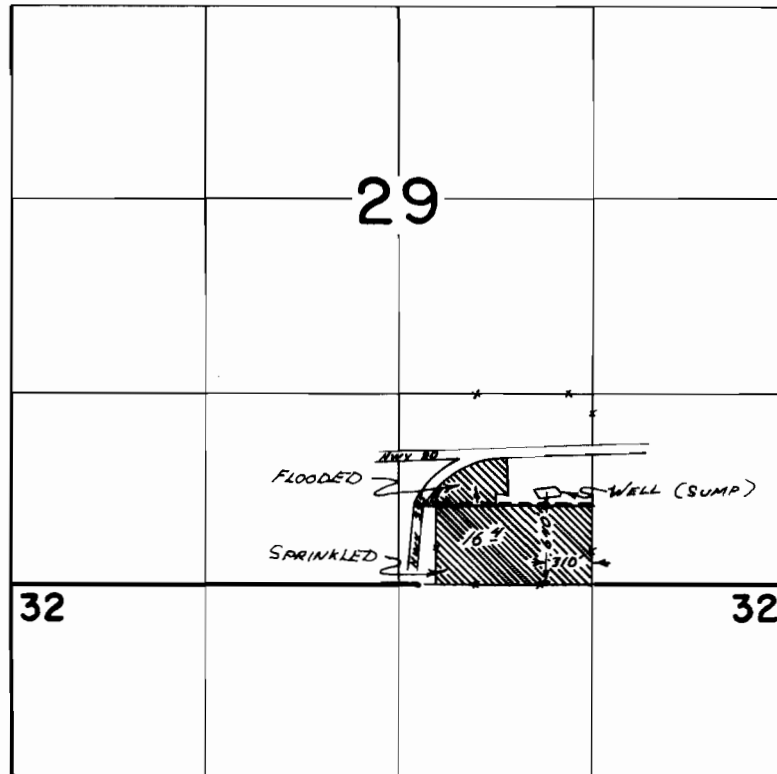

FINAL PROOF SURVEY
UNDER

Application No. *G-1130* Permit No. *G-4174*
IN NAME OF

MACOMBER'S, INC.

Surveyed *Aug. 26* 19*72*, by *R. G. MUSKEN*