


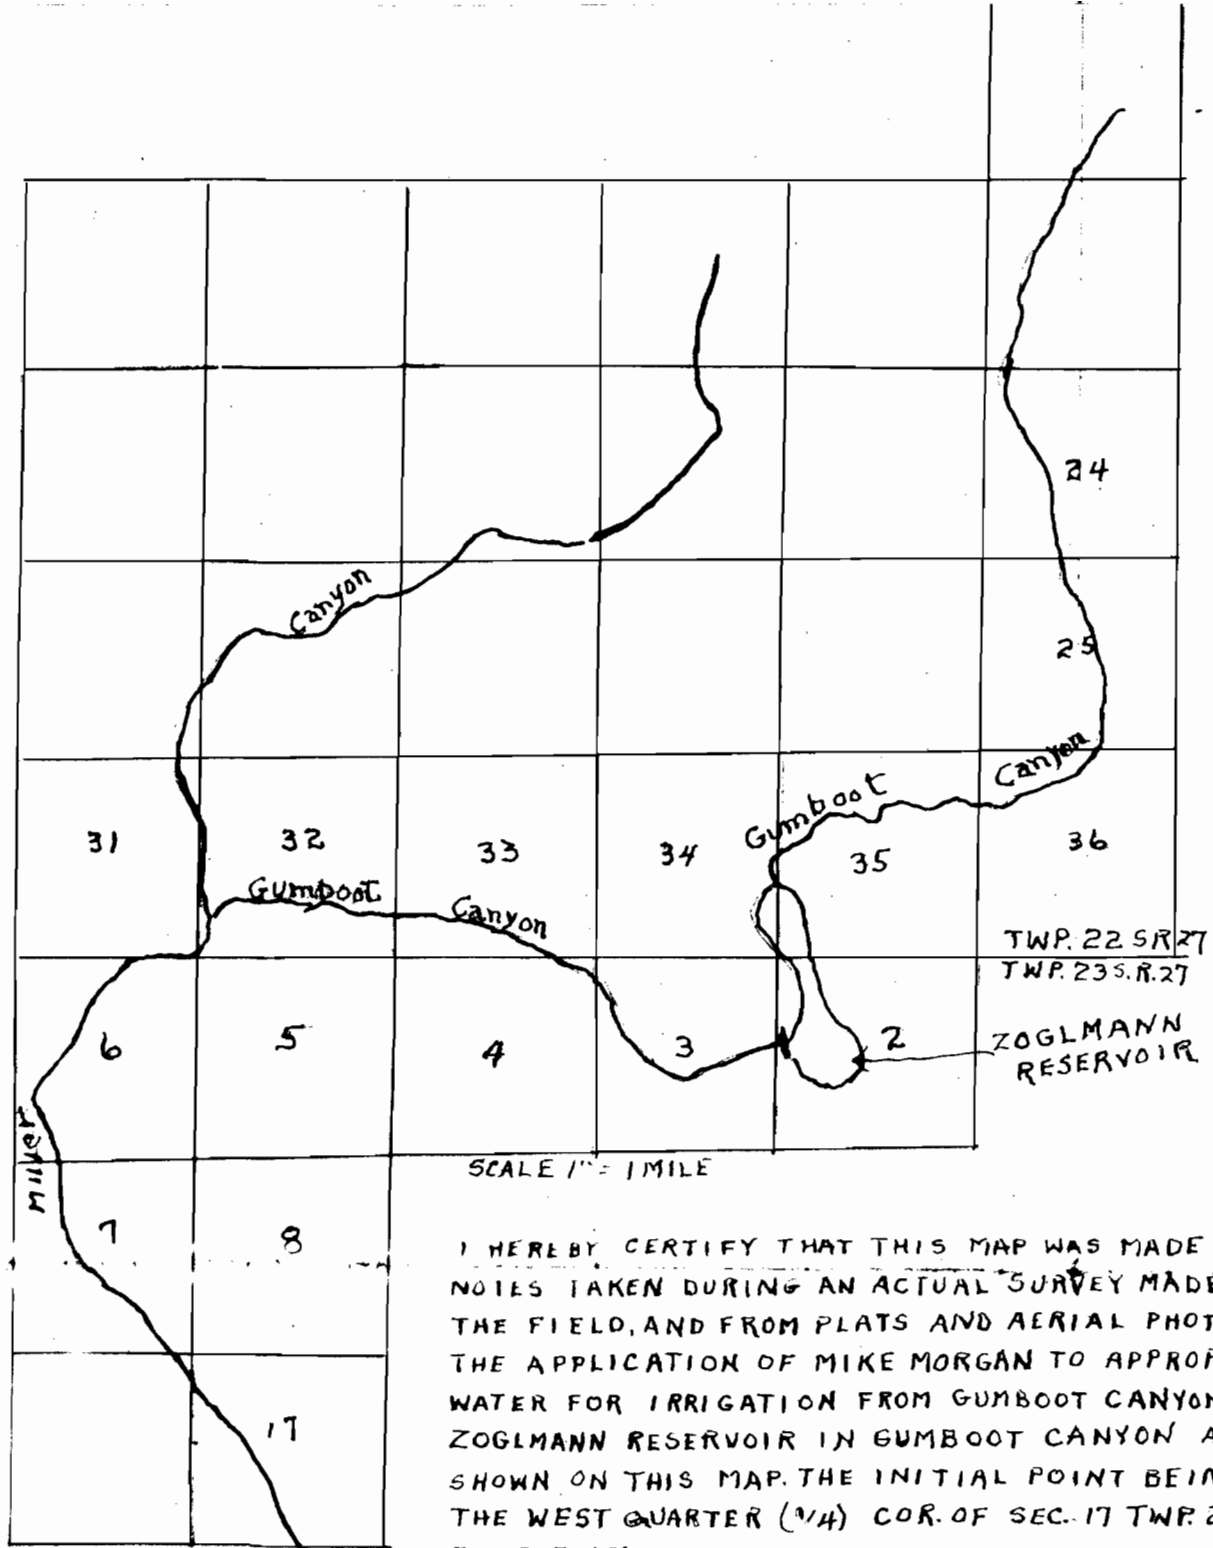

I HEREBY CERTIFY THAT THIS MAP WAS MADE FROM NOTES TAKEN DURING AN ACTUAL SURVEY MADE IN THE FIELD, AND FROM PLATS AND AERIAL PHOTO IN THE APPLICATION OF MIKE MORGAN TO APPROPRIATE WATER FOR IRRIGATION FROM GUMBOOT CANYON AND ZOGLMANN RESERVOIR IN GUMBOOT CANYON AS SHOWN ON THIS MAP. THE INITIAL POINT BEING THE WEST QUARTER (1/4) COR. OF SEC. 17 TWP. 23 S. R. 27 E.W.M.


DATED THIS 24 DAY OF MAY 1963

REGISTERED
OREGON
LAND SURVEYOR

C. N. Young

JULY 7, 1944
C. N. YOUNG
43

TWP. 23 S. R. 27

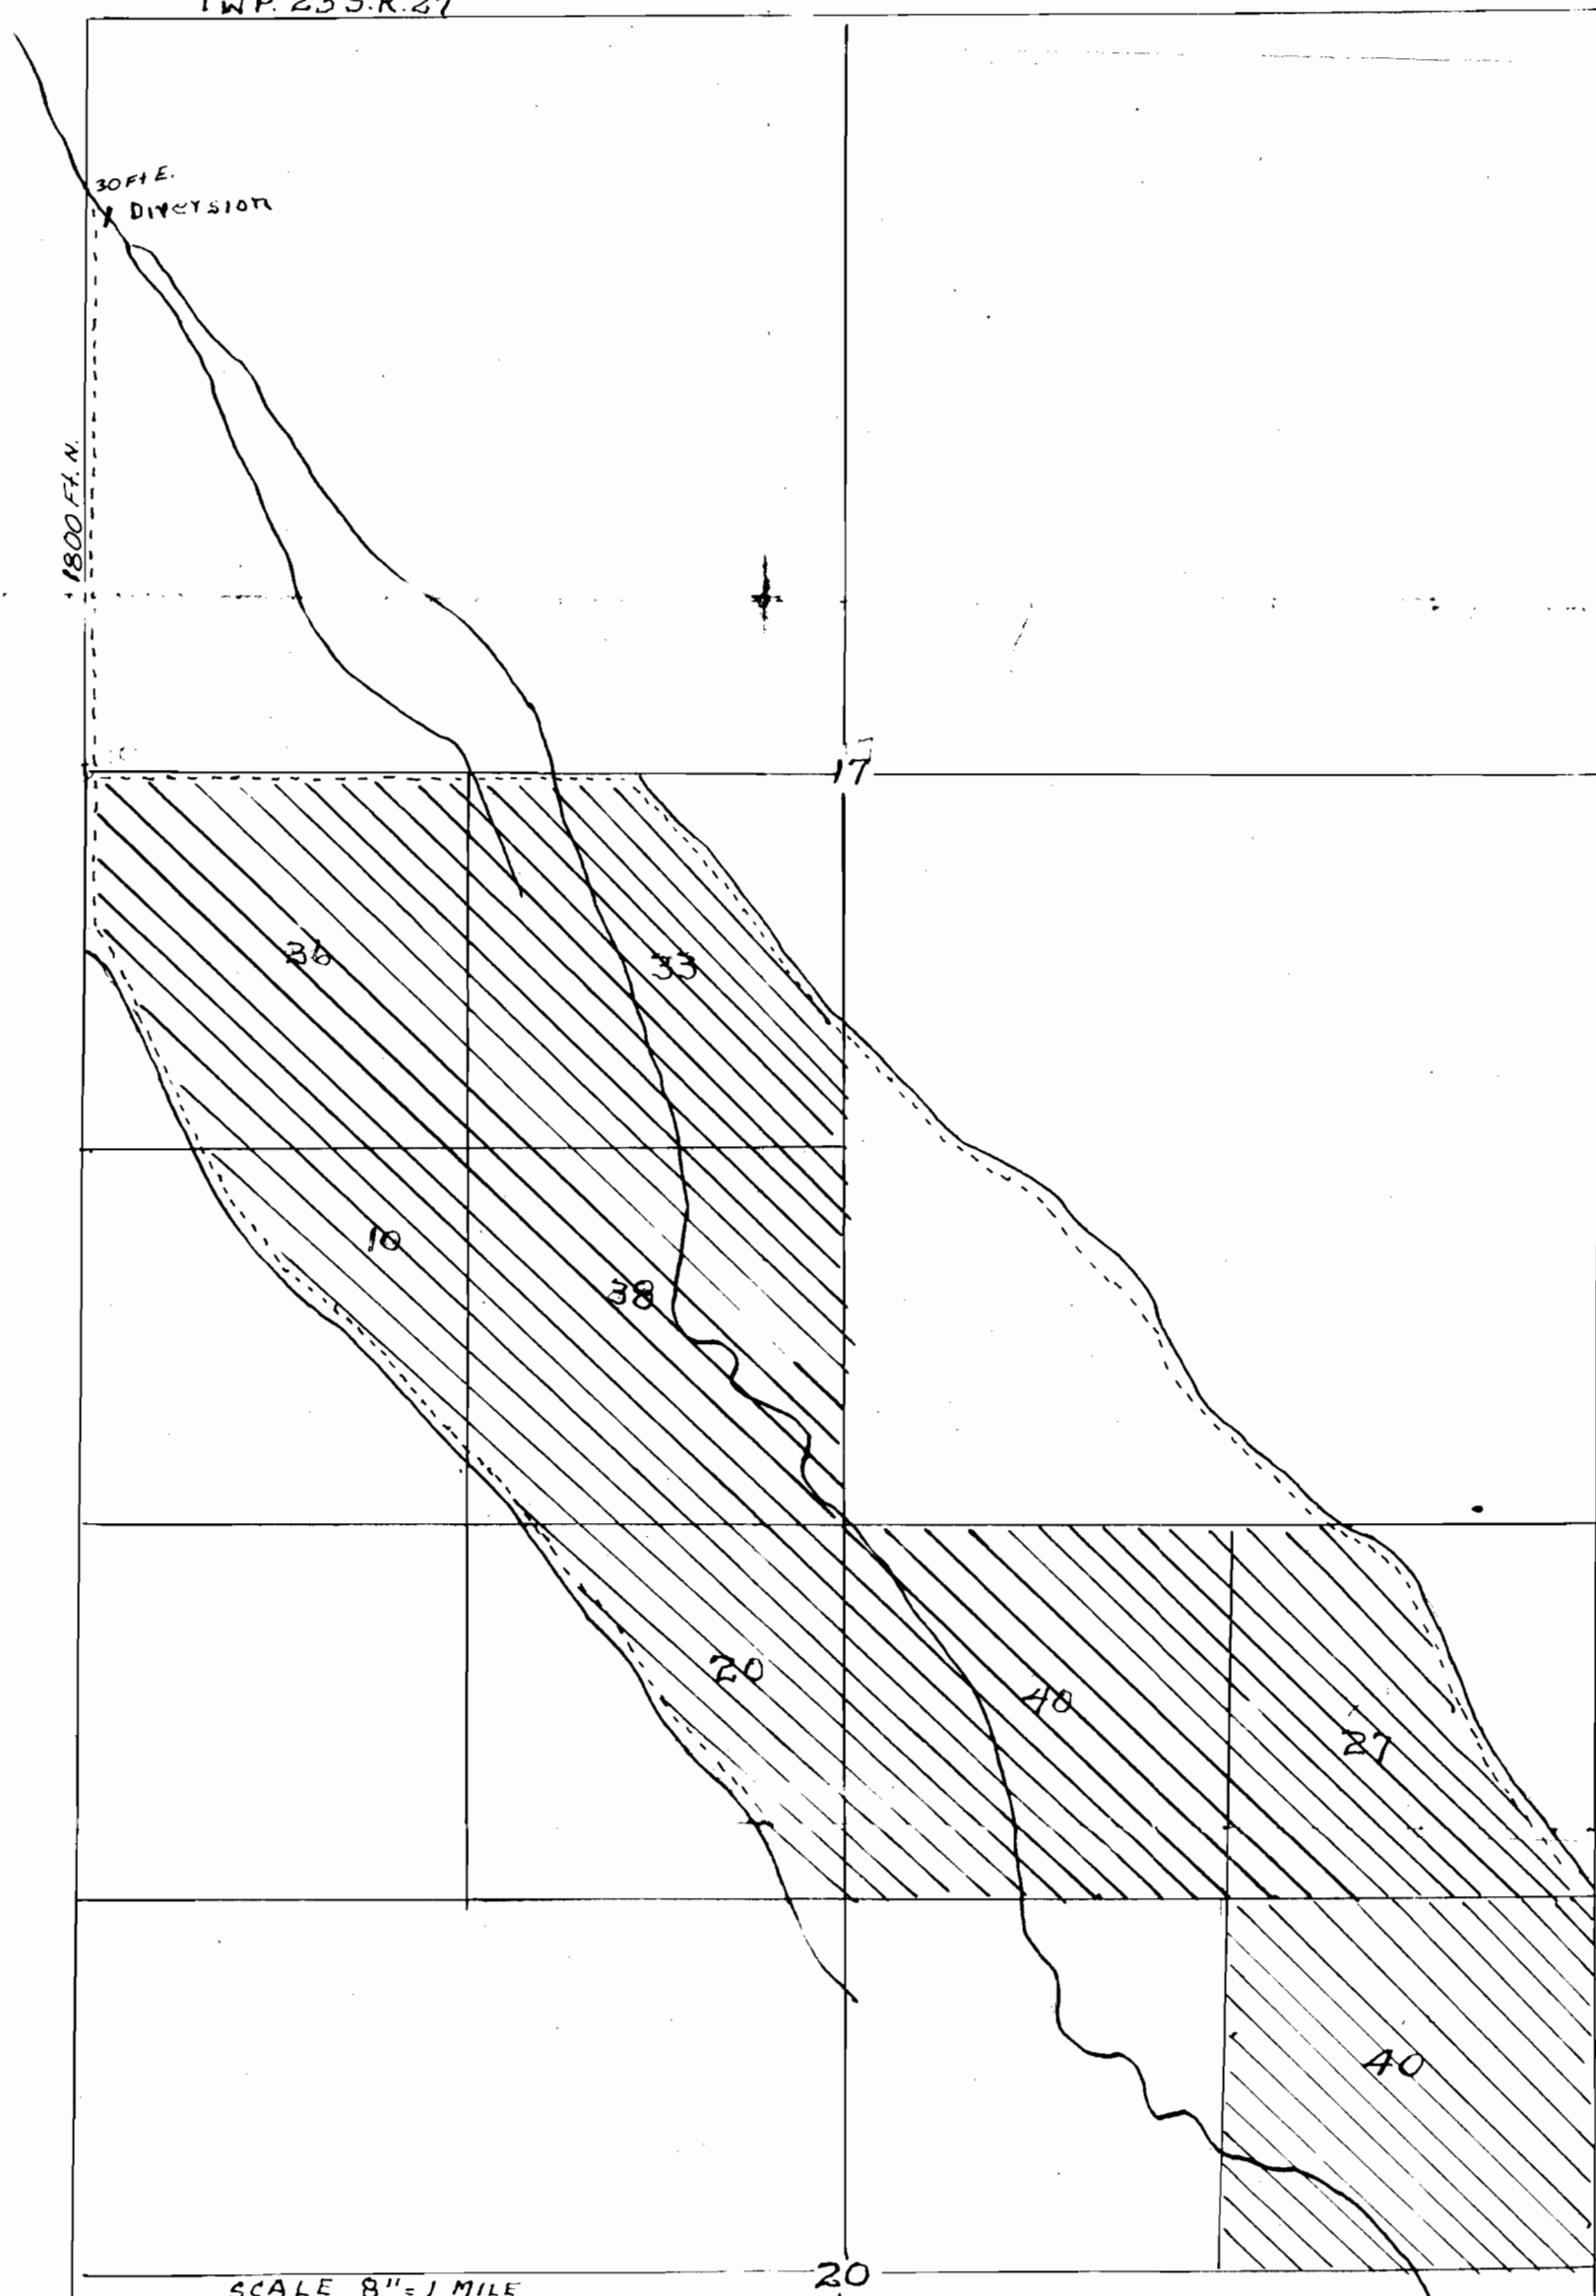

NO. 38780
R-3291, 28912