


T.23.S. R.30 E. W.M.

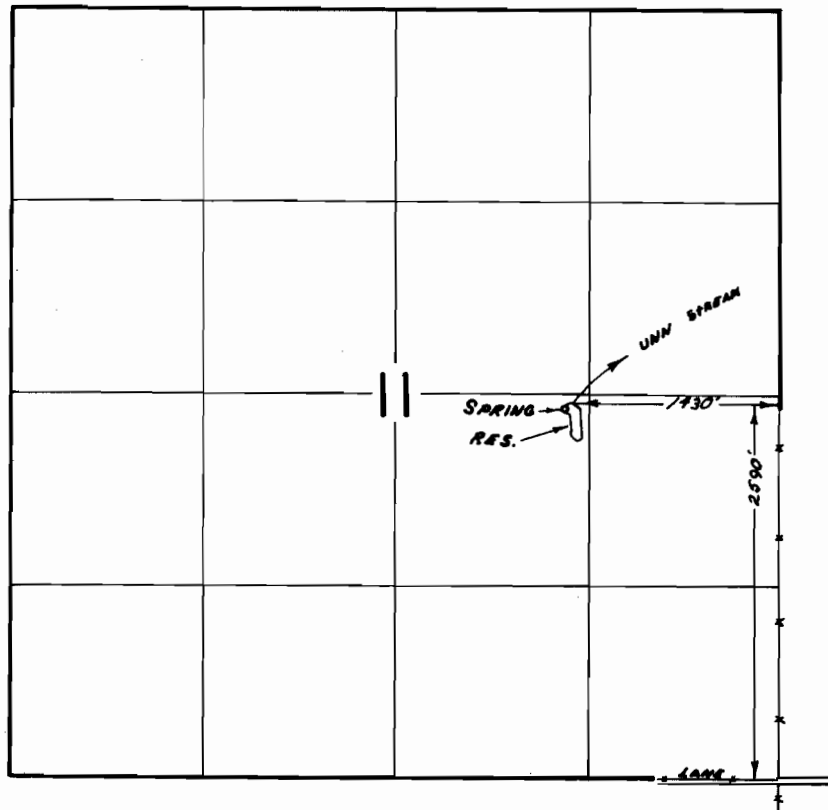

FINAL PROOF SURVEY
UNDER

Application No. P-13167 Permit No. P-1936
IN NAME OF

P. W. CLEMENS

Surveyed AUG. 22, 1972, by P. R. MURPHY