


T. 40S., R. 8W., W.M.

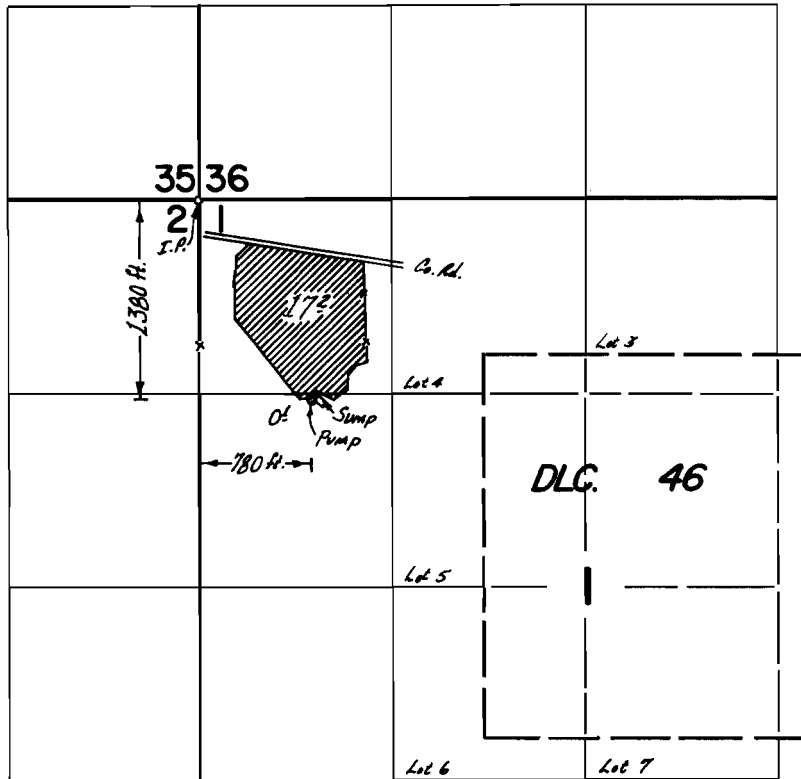

FINAL PROOF SURVEY
UNDER

Application No. G-3827 Permit No. G-3607
IN NAME OF

RAY L. JAMES

Surveyed 30 Oct. 1972, by L.F. GOULD