


T. 23 S. R. 30 E. W. M.

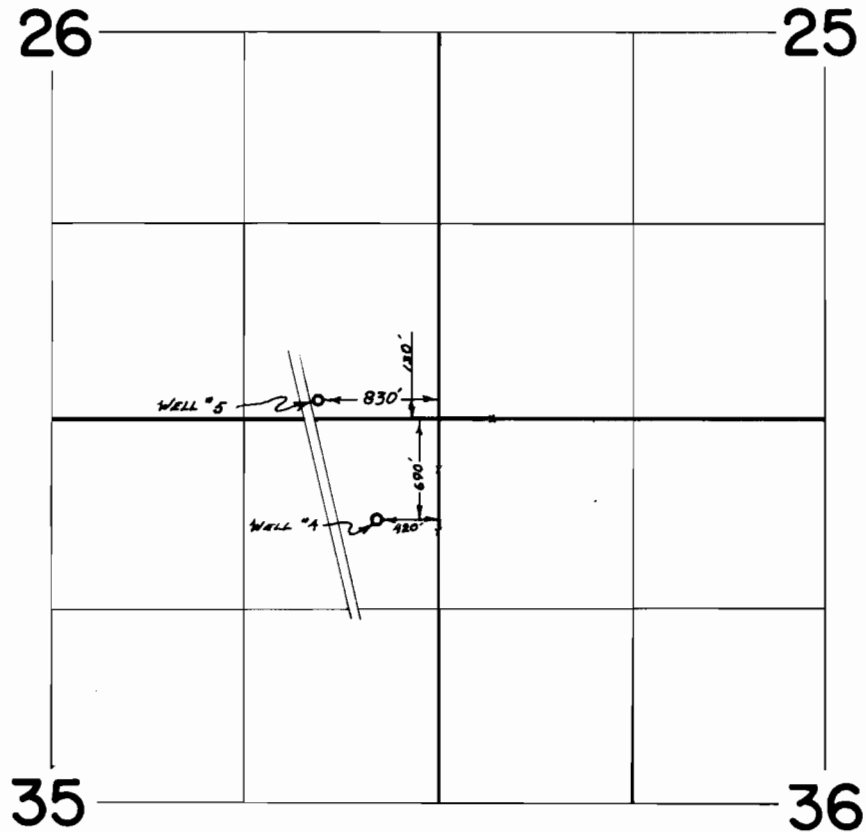

**FINAL PROOF SURVEY**  
UNDER

Application No. *G-3121* / *G-3122* Permit No. *G-2913* / *G-2914*  
IN NAME OF

.....**EDWARD HINES LUMBER CO.**.....

Surveyed *Aug. 28* 19*72*, by *R. G. MUCKEN*