


T. 36 S. R. 7 W. W.M.

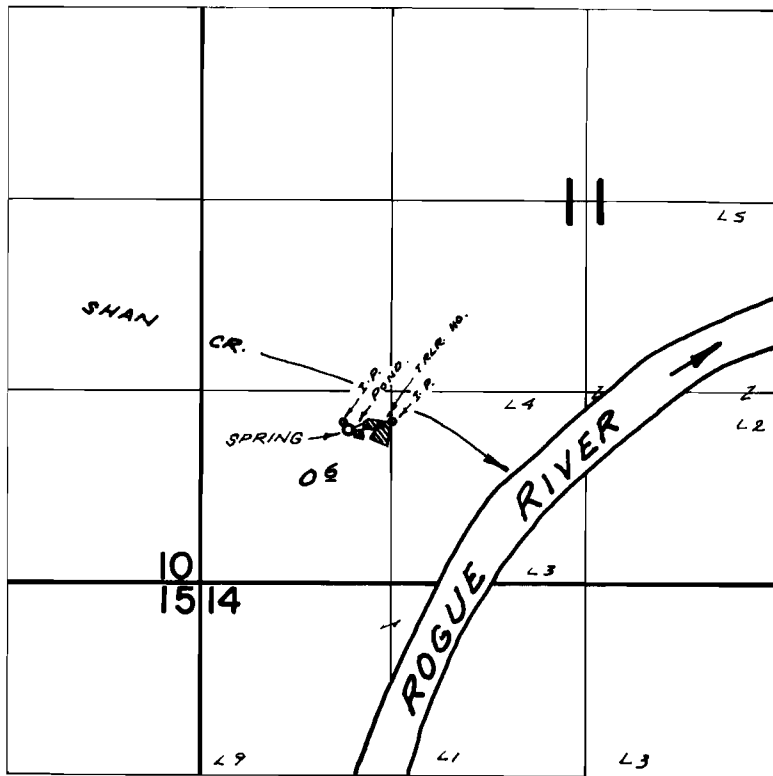

SPRING LOC: 270'S. E 300'W. FROM NE COR. SW 1/4 SW 1/4 SEC. 11

FINAL PROOF SURVEY UNDER

Application No. 44115 Permit No. 32792
IN NAME OF

VIRGINIA DEYERMIN

Surveyed APR. 19, 1972, by R. MUCKEN