


# T.34S.R.6W.W.M.

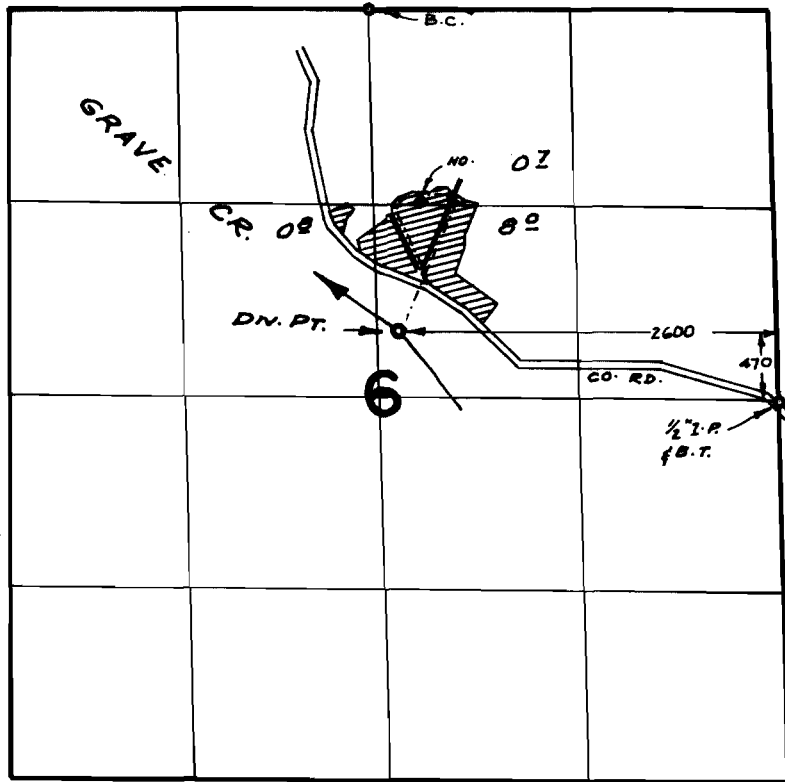

## FINAL PROOF SURVEY UNDER

Application No. 43907 Permit No. 32816  
IN NAME OF

*THOMAS K. & DONNA J. JOSSERAND*

Surveyed APR. 12, 1972, by R. MUCKEN