


MAP
Showing Sections 3 and 10
of Township 26 S.R. 13 W. N.M.
Coos Co. Ore.

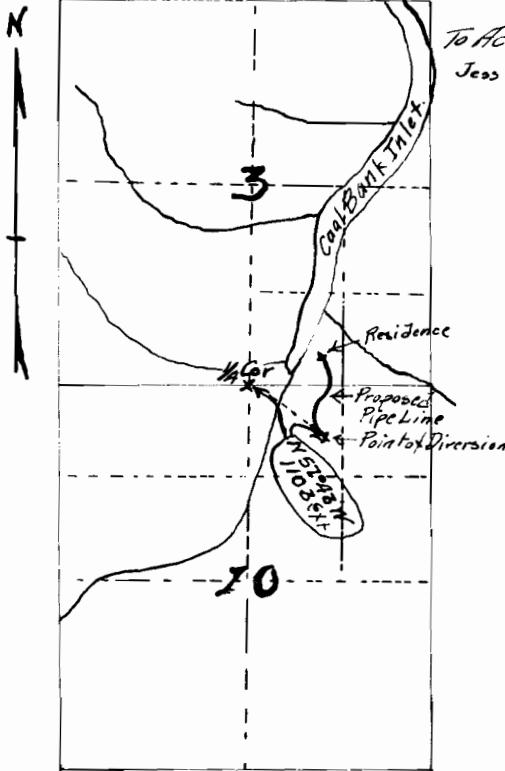

Scale
1 inch = 40 chains.

To accompany application of
Jesse Kyle to appropriate water

D. L. Buckingham
19

I, D. L. Buckingham, of Marshfield, Oregon
hereby certify that this map was made from
notes taken during an actual survey made by
me Aug 6-1922, and that it correctly represents
the works described in the accompanying application
together with the streams and pipelines included.

D. L. Buckingham

A-8582
P-5585