


T.36S.R.6W.W.M.

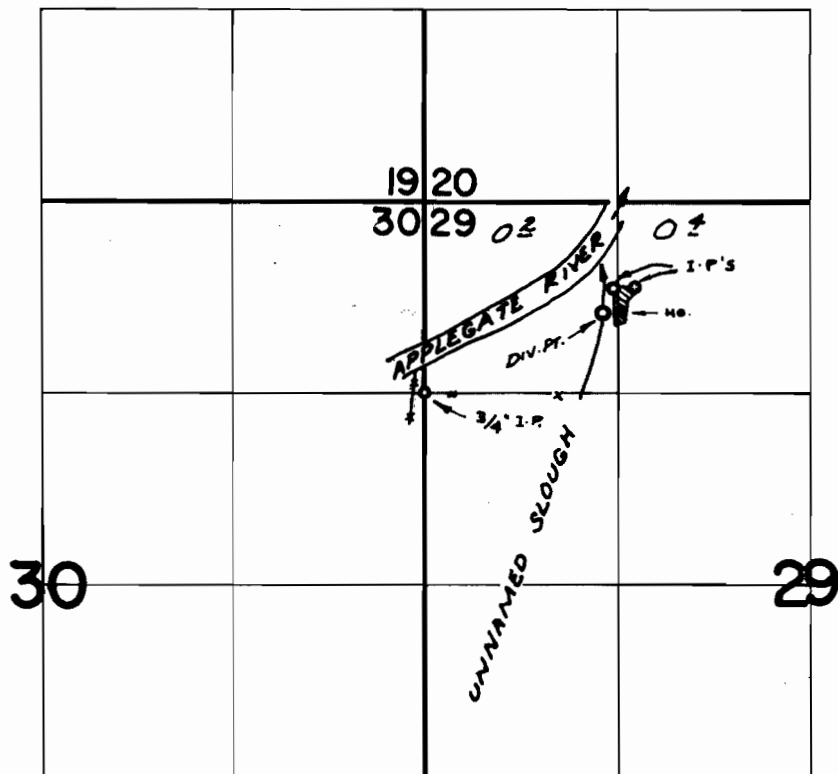

DIV. PT. LOC: 550' N. & 1230' E. FROM S.W. COR. NW 1/4 NW 1/4 SEC. 29

FINAL PROOF SURVEY UNDER

Application No. 46074 Permit No. 34428
IN NAME OF

GEORGE B. & ROSEMARY CRESS

Surveyed APR 10, 1972, by R. MUCKEN