


T.36S.R.6W.W.M.

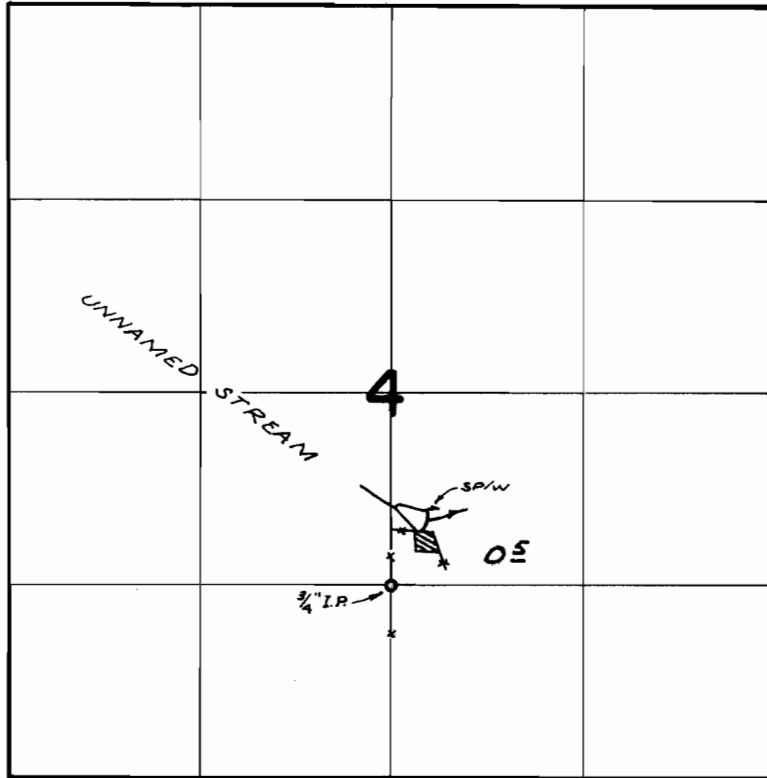

DIV. PT. LOC: 440' N. & 250' E. FROM S.W. COR. NW 1/4 SE 1/4 SEC. 4

**FINAL PROOF SURVEY**  
UNDER

Application No. <sup>R-38880</sup> ~~38881~~ Permit No. <sup>R-3884</sup> ~~29201~~  
IN NAME OF

..... G. P. STEPPE .....

Surveyed APR. 14, 1972, by R. MUCKEN