


T.36S.R.6W.W.M.

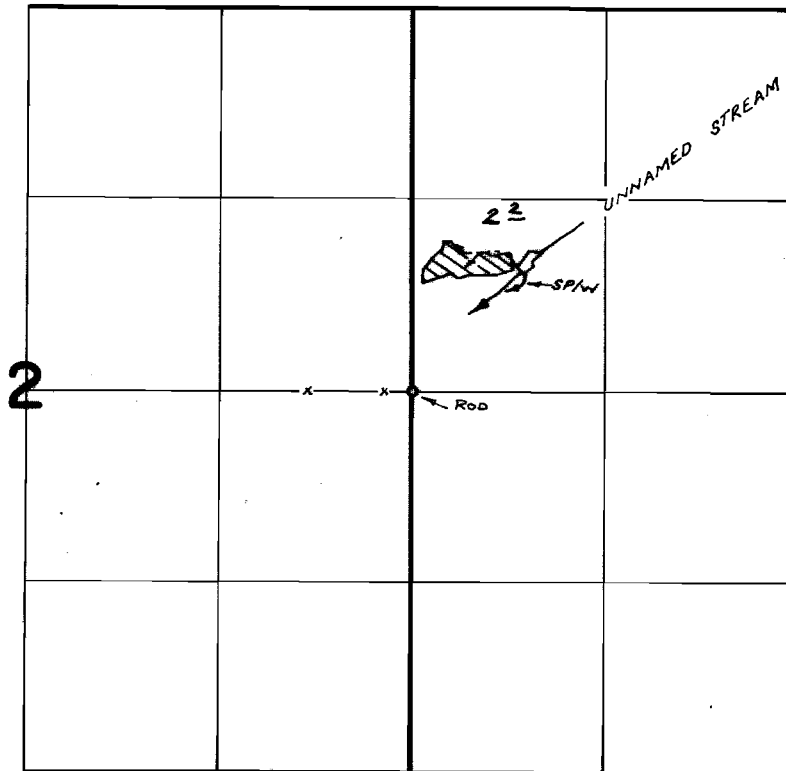

DIV. PT. LOC: 750'E & 830'N. FROM W 1/4 COR. SEC. 1

FINAL PROOF SURVEY
UNDER

R-43563 R-5003
Application No. 43564 Permit No. 32529
IN NAME OF

THOMAS W. HILL

Surveyed APR. 15 1972. by R. MURKEN