T. 36 S. R. 5 W. W. M.

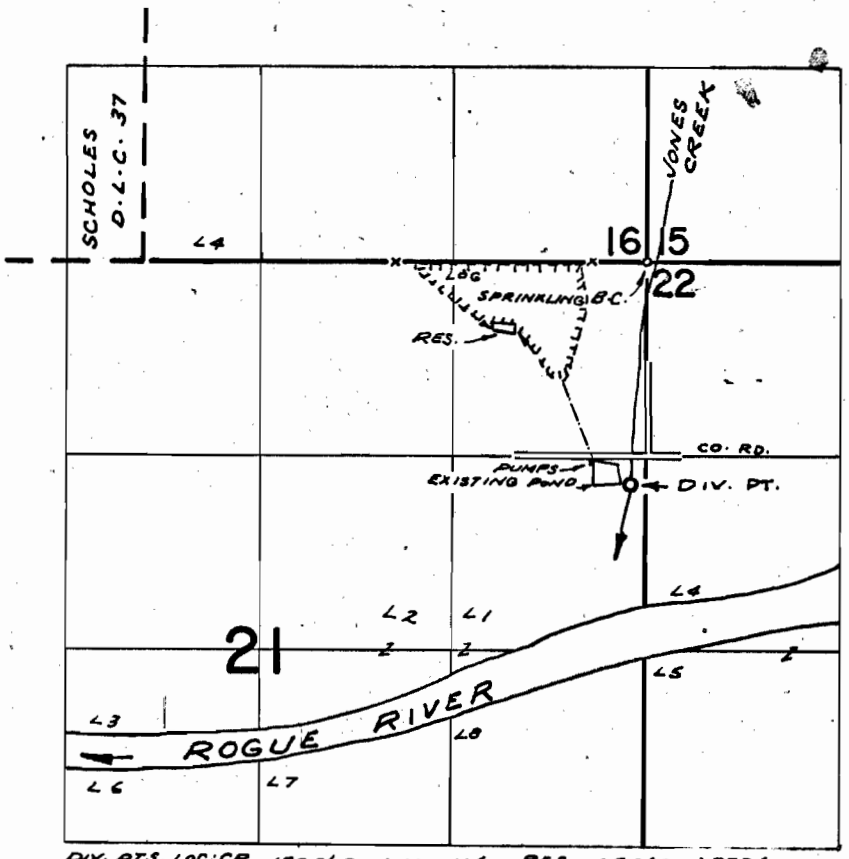

DIV. PTS. LOC: CR-1505'S. & 110'W.; RES.-450'S. & 970'W, BOTH FROM N.E. COR. SEC. 21

FINAL PROOF SURVEY

UNDER

Application No. R-47000 47001 Permit No. R-5638 35163

IN NAME OF

SPALDING & SON, INC.

Surveyed APR. 20, 1972, by R. MUCKEN

1972-J