


# T. 36 S. R. 5 W. W.M.

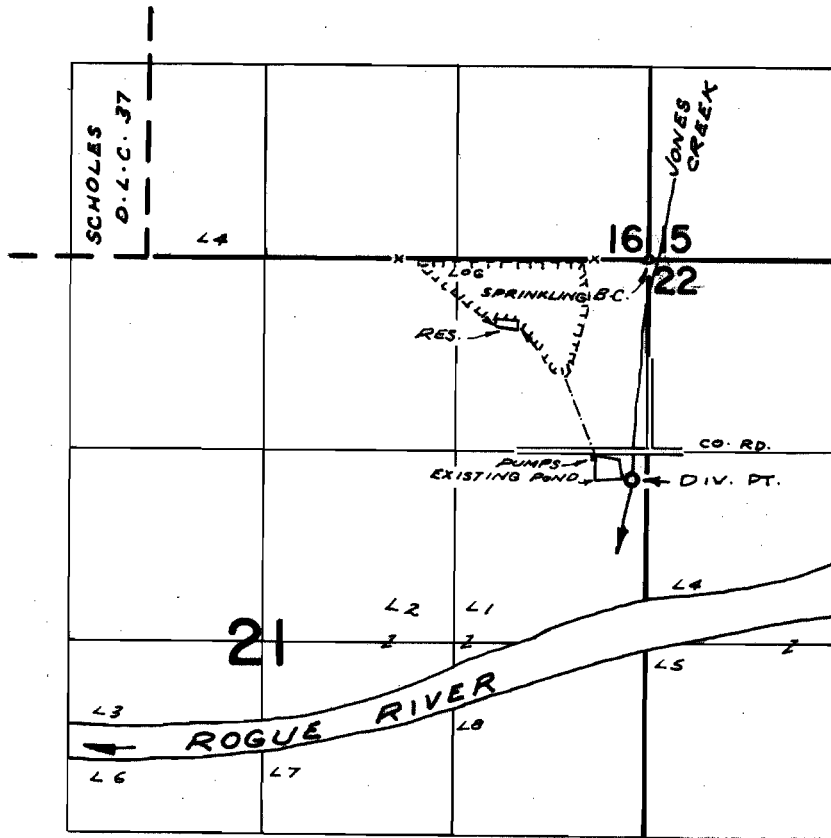

DIV. PTS. LOC. CR-1505'S. & 110' W.; RES.-450'S. & 970' W.,  
BOTH FROM N.E. COR. SEC. 21

## FINAL PROOF SURVEY UNDER

R-47000                      R-5638  
Application No. 47001    Permit No. 35163  
IN NAME OF

SPALDING & SON, INC.

Surveyed APR. 20, 1972, by R. MUCKEN