


T. 4 S., R. 2 W. W.M.

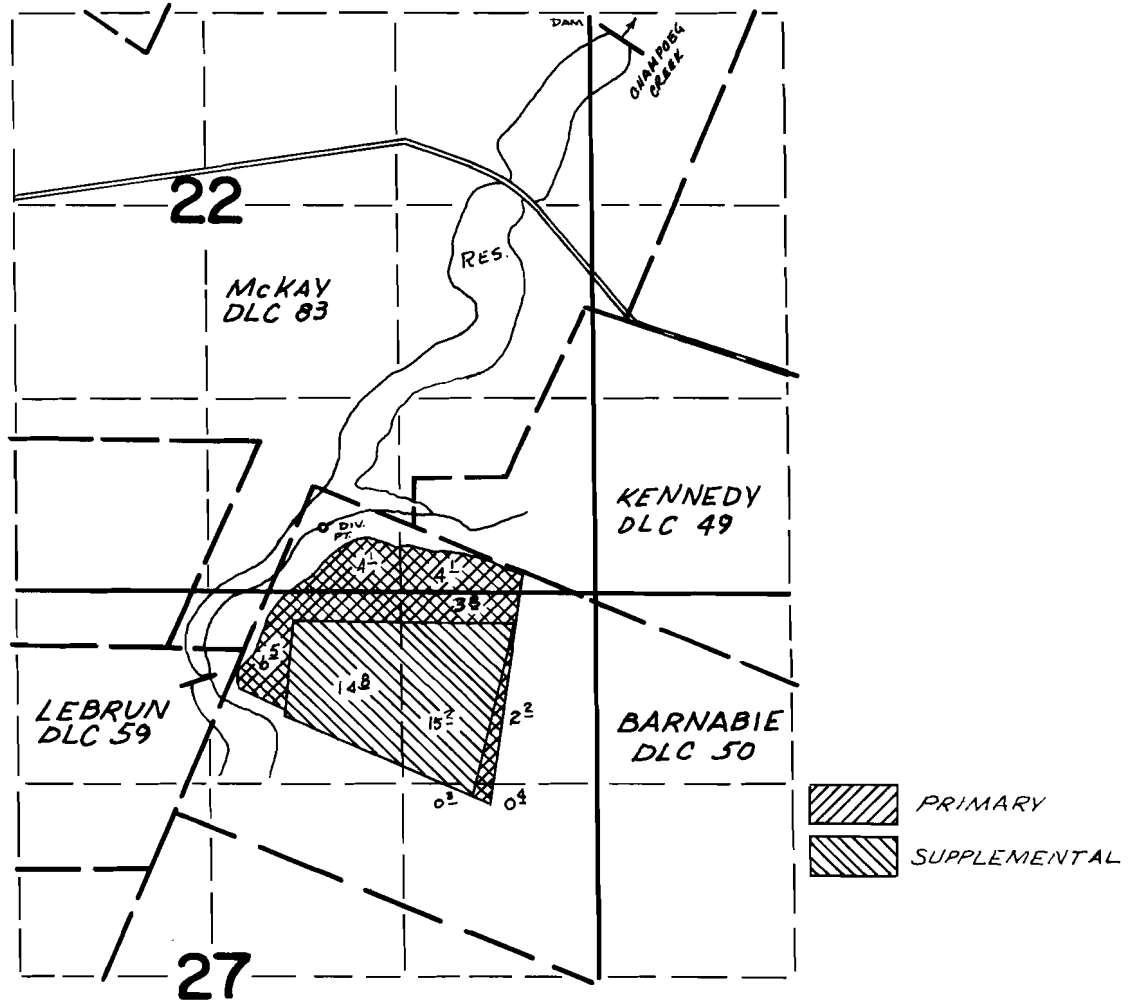

DIV. PT. LOCATED: 360' S & 1250' W FROM W'LY INT. "L" COR KENNEDY DLC 49
 DAM LOCATED: 3000' N & 820' E FROM W'LY INT. "L" COR KENNEDY DLC 49

FINAL PROOF SURVEY UNDER

Application No. 45739 Permit No. 34601
 IN NAME OF

EDGAR W. CROSBY, JR. & ELLEN MARIE CROSBY

Surveyed Oct. 6 1972, by D. Norby