


T.6S., R.1E., W. M.

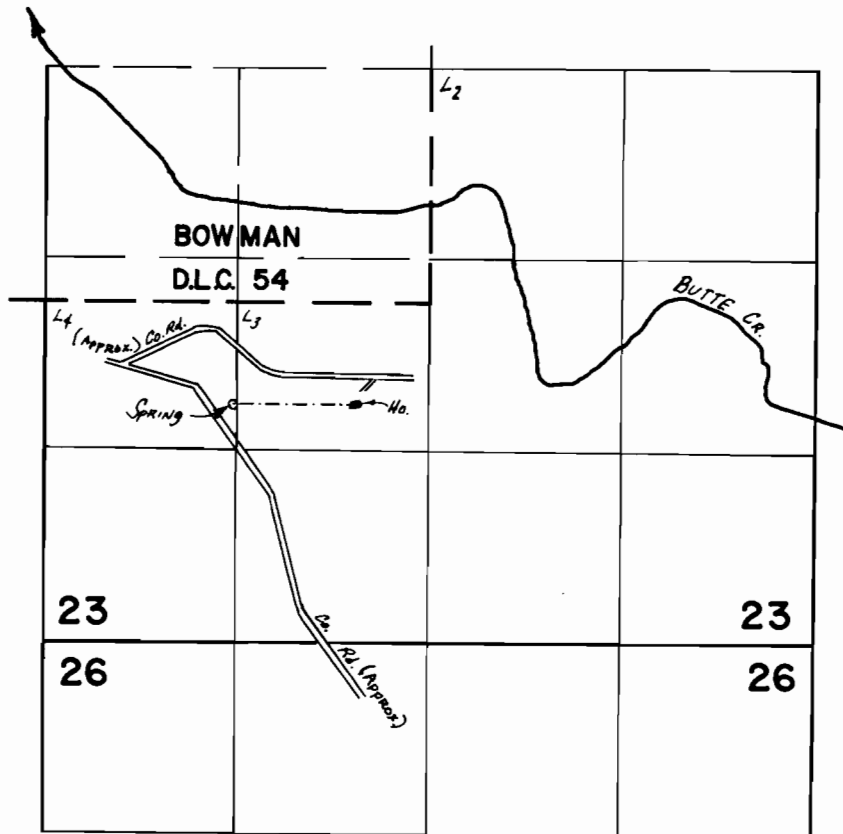

Diversion Pt. located 700' S. & 20' W. from the NW cor. Lot 3
Sec. 23.

FINAL PROOF SURVEY
UNDER

Application No. 47452 Permit No. 35550
IN NAME OF

VINCENT G. TILL

Surveyed Oct. 13 1972, by R.G. Mucken