


T.5S., R.6W., W.M.

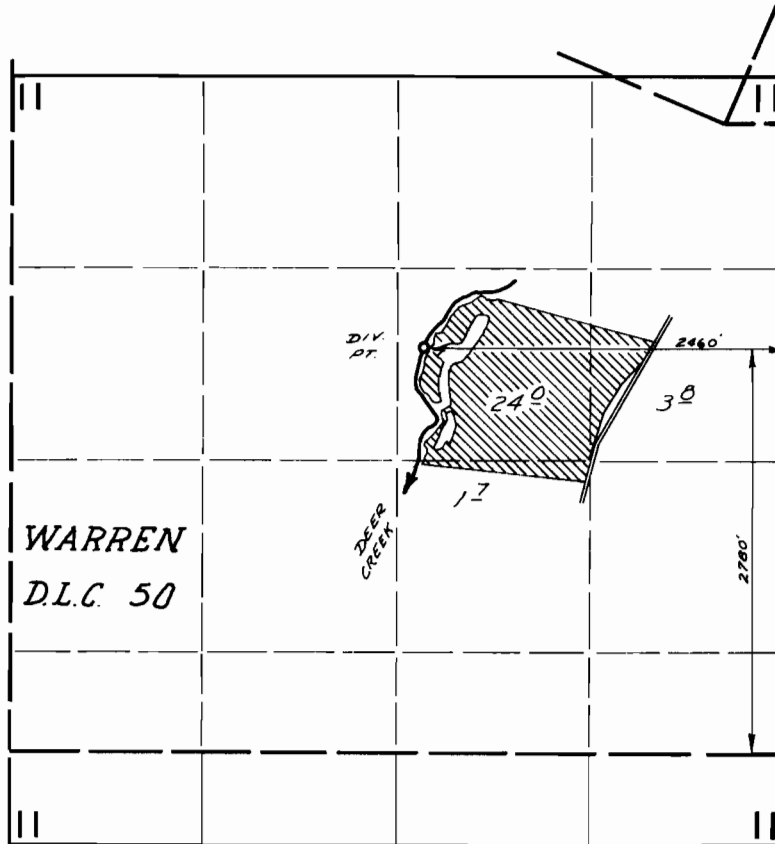

FINAL PROOF SURVEY
UNDER

Application No. 41081 Permit No. 30604
IN NAME OF

DAVID L. CARSON

Surveyed Oct. 29 1973, by D. NORBY