


T.5S., R.6W., W.M.

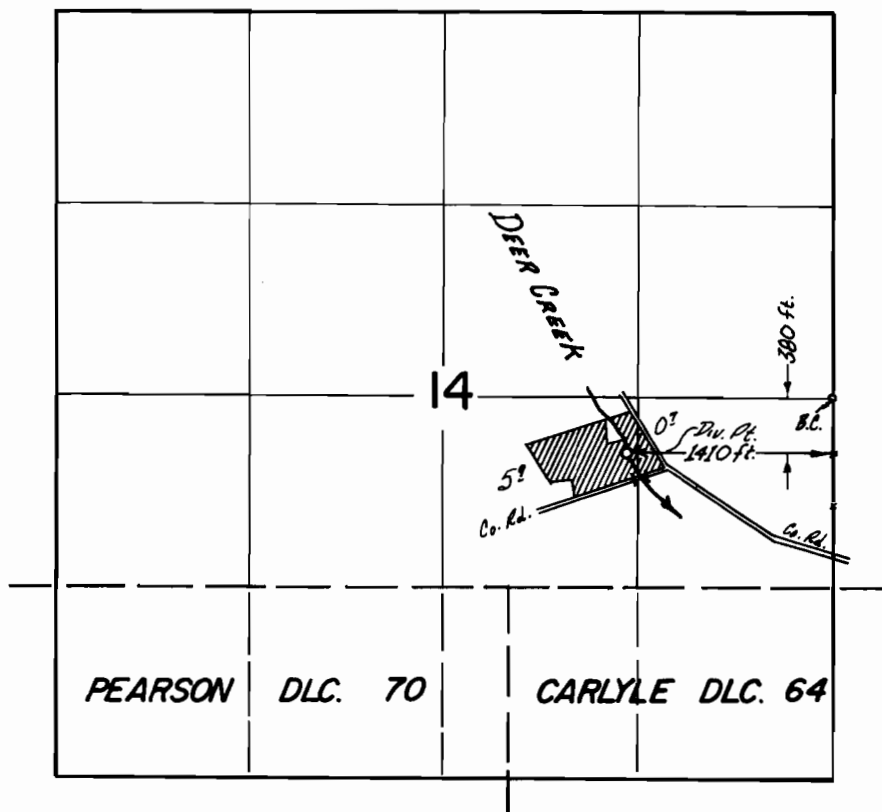

FINAL PROOF SURVEY
UNDER

Application No. 41317 Permit No. 30852
IN NAME OF

EARL H. SMITH

Surveyed 20 JUNE 1972, by D. NORBY