


T.5S., R.6W., W.M.

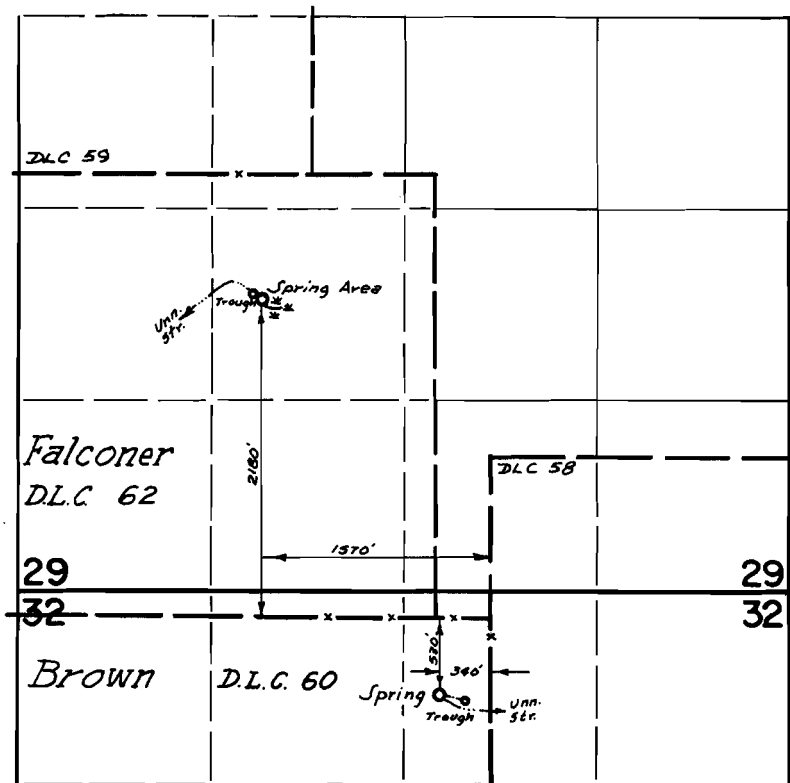

FINAL PROOF SURVEY UNDER

Application No. 43383 Permit No. 32438
IN NAME OF

ROBERT GALINAT

Surveyed June 21 1972, by D. Norby