


T5S., R.7W., W.M.

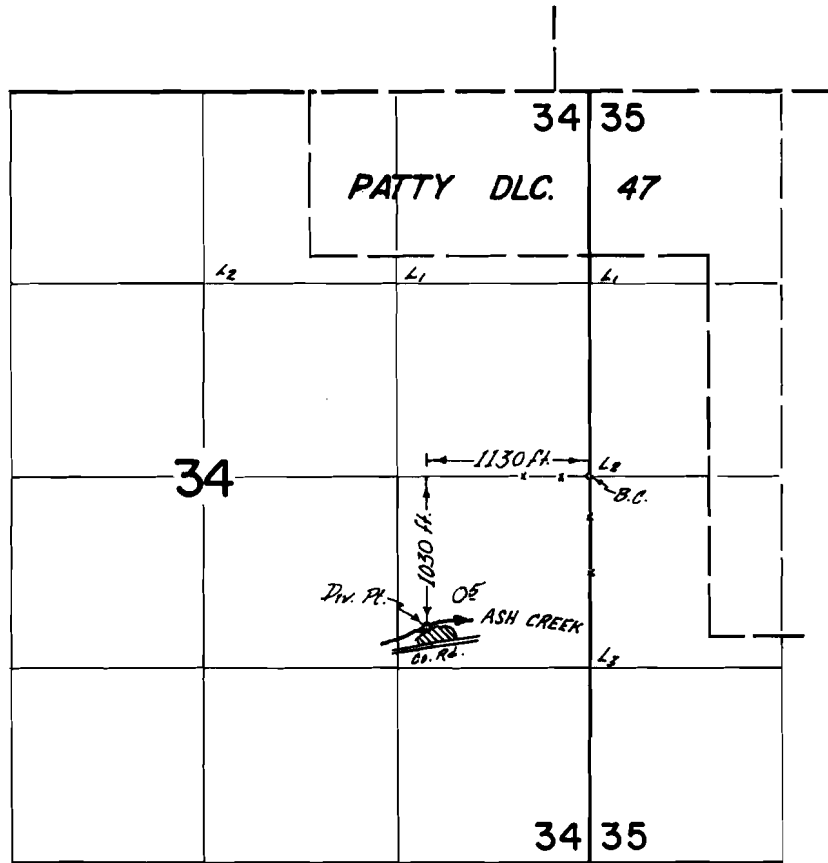

**FINAL PROOF SURVEY**  
UNDER

Application No. 46185 Permit No. 34602  
IN NAME OF

JOHN BUSWELL

Surveyed 5 JULY 19 72, by D. NORBY