


# T.4S.R.3W.W.M.

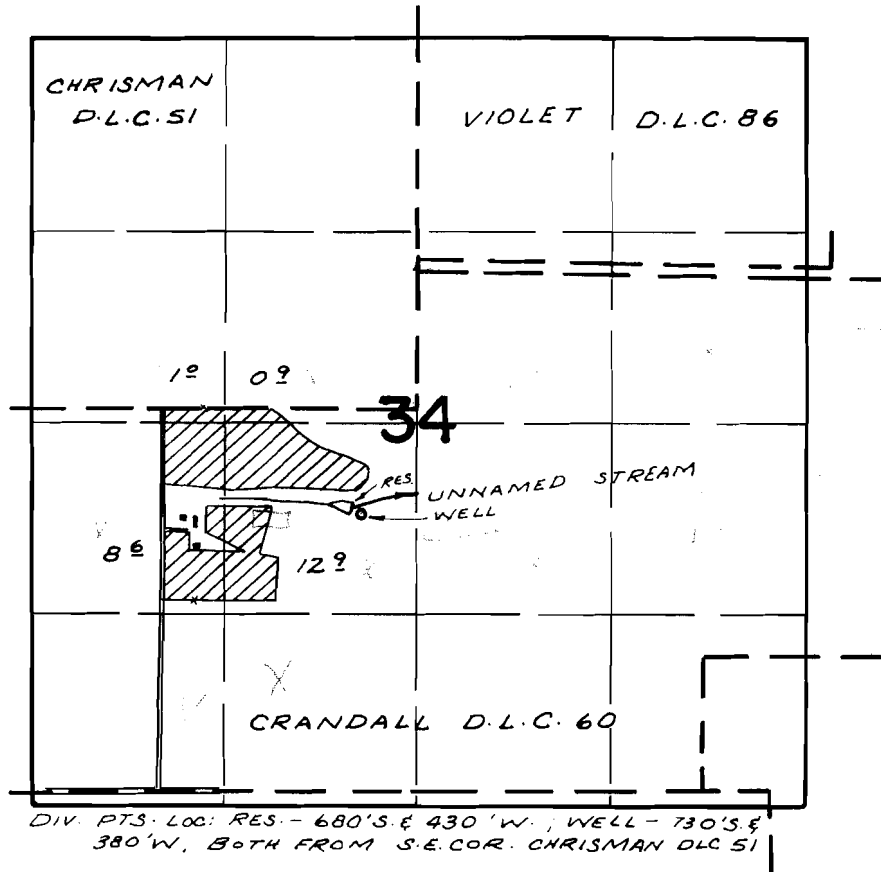

## FINAL PROOF SURVEY UNDER

R-40381                      R-4548  
 40382                        30262  
 Application No. G-3867    Permit No. G-3640  
 IN NAME OF

IVIE A. MICHAEL

Surveyed Nov. 9, 1972, by R. MUCKEN