


T.4S.R.3W.W.M.

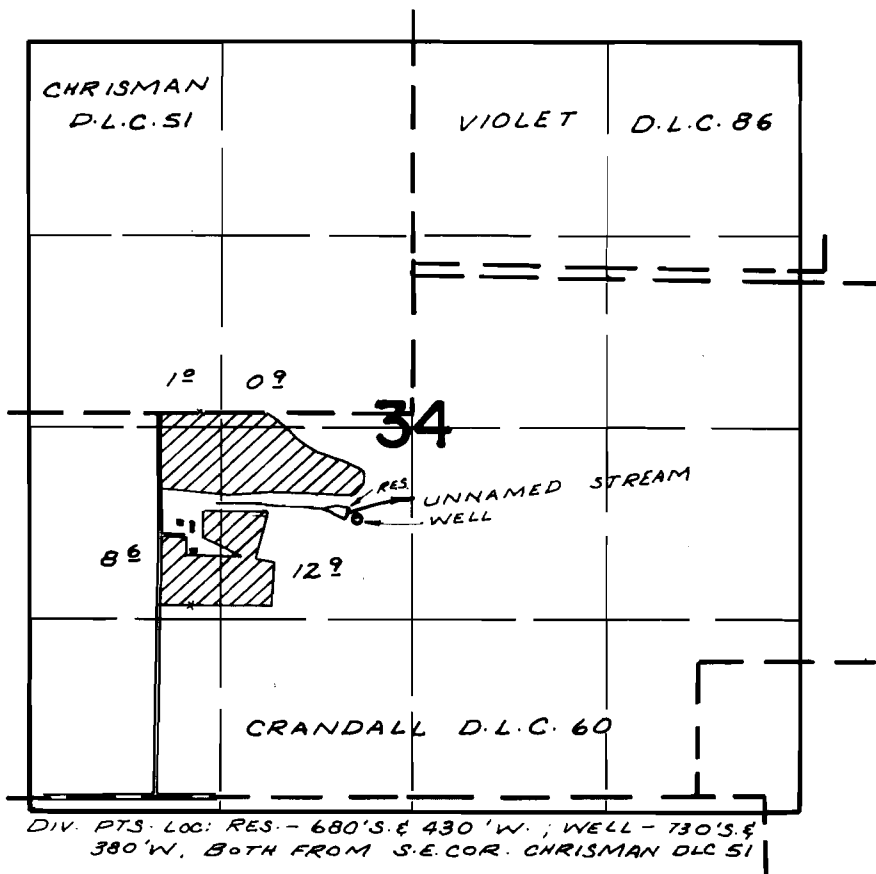

FINAL PROOF SURVEY UNDER

R-40381 R-4548
 40382 30262
 Application No. G-3867 Permit No. G-3640
 IN NAME OF

IVIE A. MICHAEL

Surveyed Nov. 9, 1972, by R. MUCKEN