


T.4&5S., R3W., W.M.

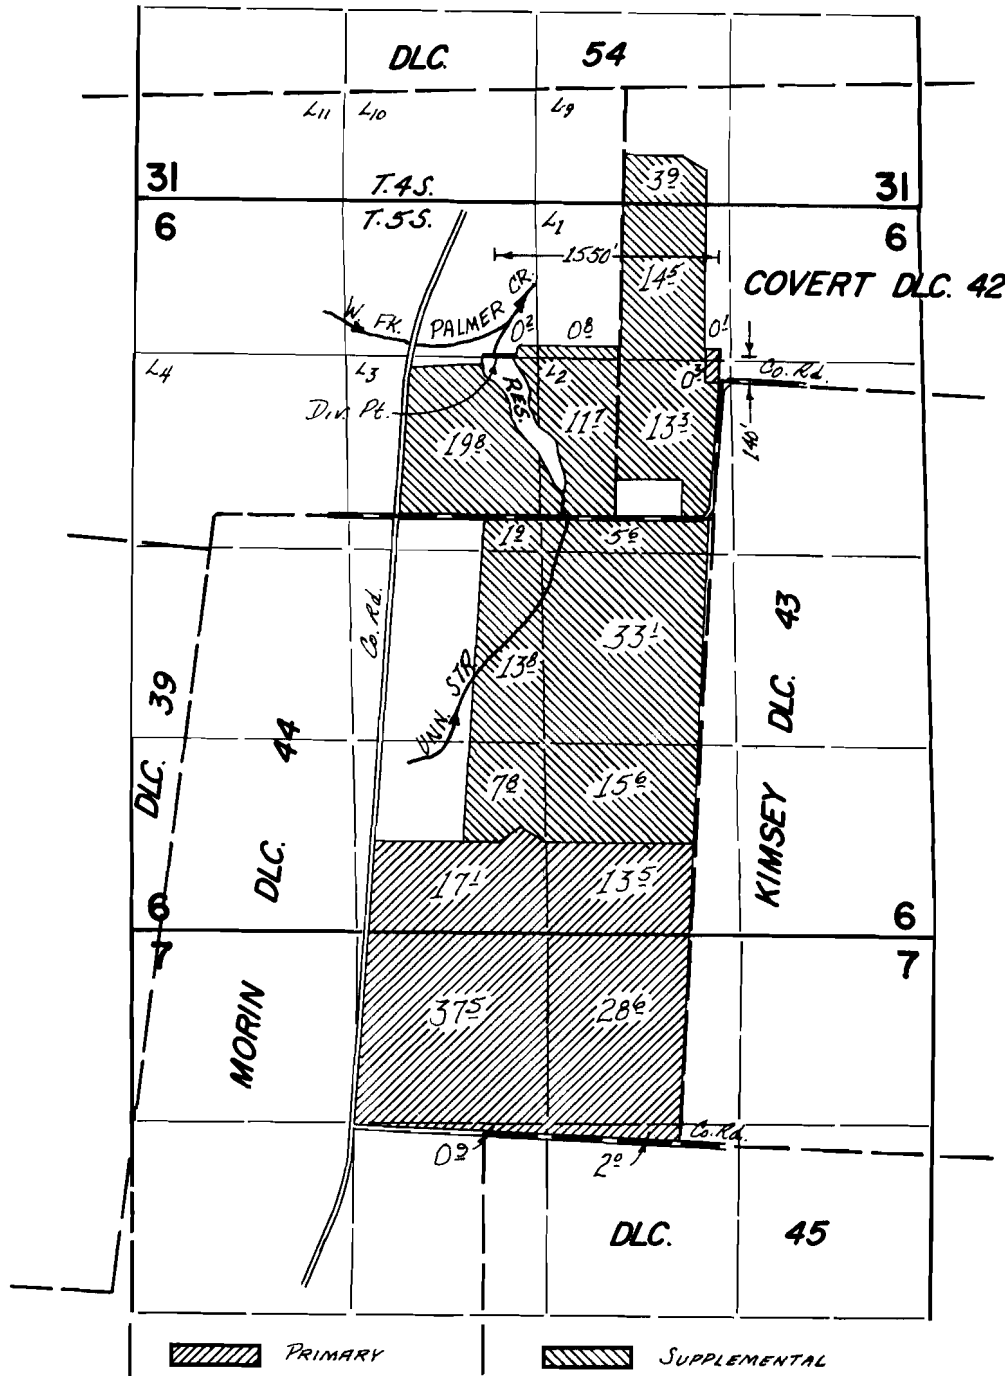

FINAL PROOF SURVEY
UNDER

R-42921 R-4838
Application No. 42922 Permit No. 31859
IN NAME OF

ROBERT L. STOCKHOFF

Surveyed 10 Nov. 19 72, by D. NORBY