


T.28S.,R.12&13W.,W.M.

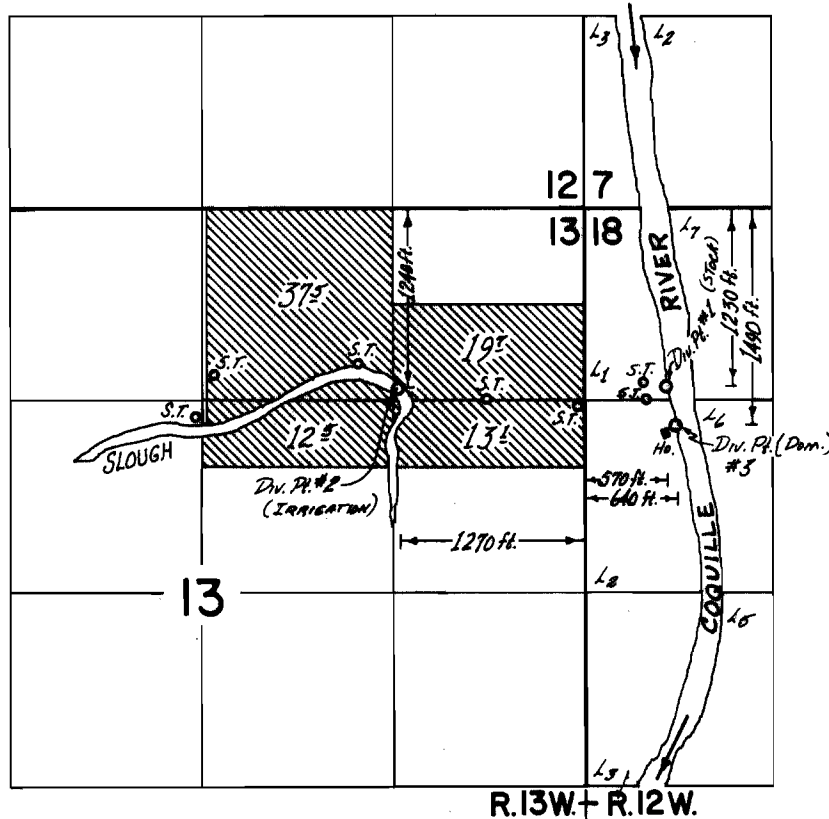

**FINAL PROOF SURVEY**  
UNDER

Application No. 39648 Permit No. 29458  
IN NAME OF

JOHN & HENRY ISENHART, ONA & CLATIE SMITH

Surveyed 17 JULY 1972, by L. E. GOULD