


T.27S., R.12W., W.M.

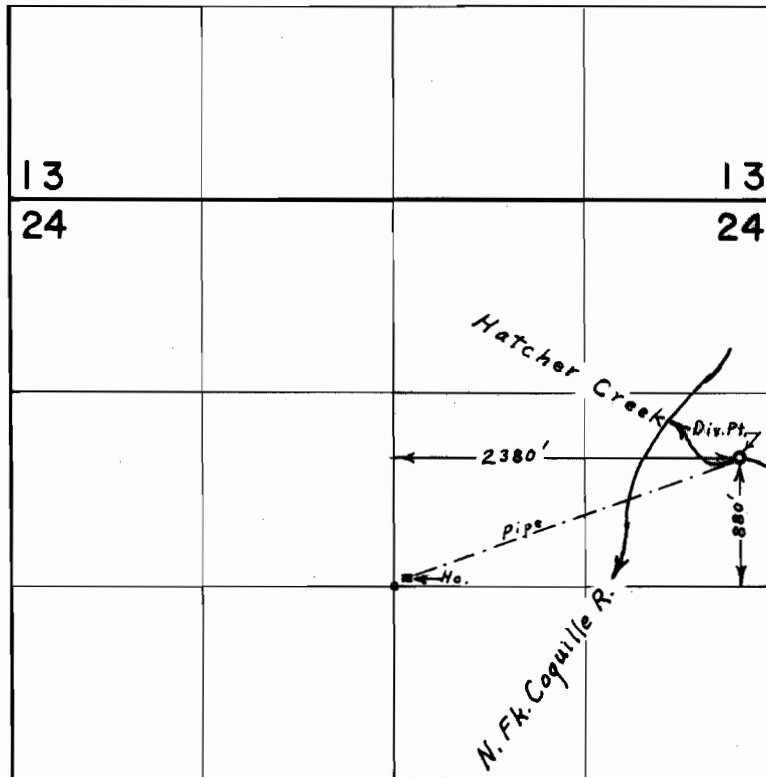

FINAL PROOF SURVEY
UNDER

Application No. 39652 Permit No. 29461
IN NAME OF

KENNETH G. EBERWEIN

Surveyed July 11, 1972, by L. E. Gould