


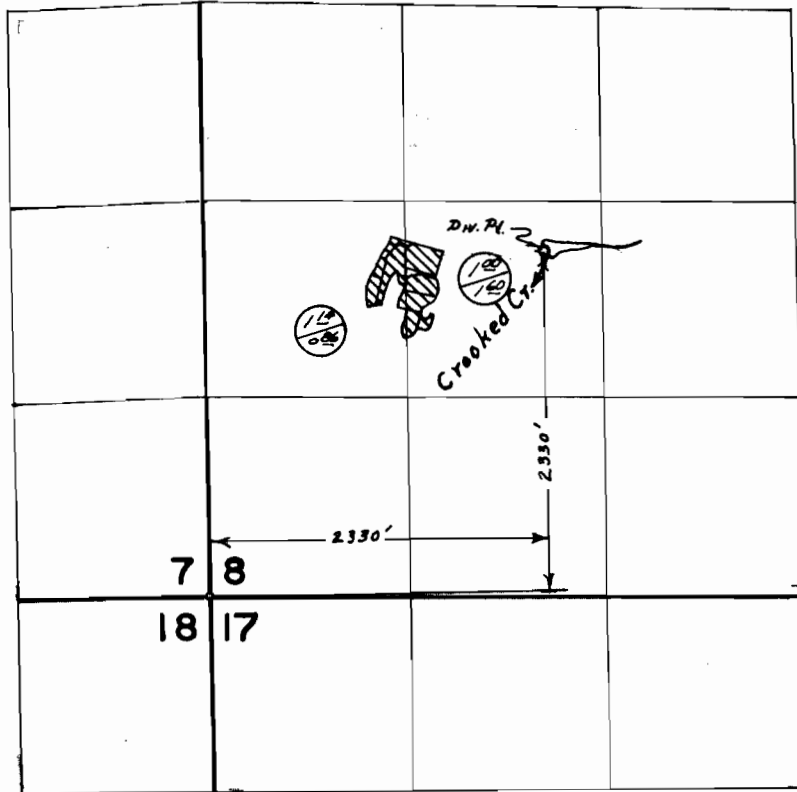

T. 29 S. R. 14 W. W. M.



 Permit 32375 (Irrigation, Frost Control, & Harvesting)  
 Certificate 21256 (Frost Control & Harvesting)

**FINAL PROOF SURVEY**  
UNDER

Application No. 43263 Permit No. 32375  
IN NAME OF

LORIS A. WILLET

Surveyed April 15, 1972, by L. E. Gould