


T.29S. R.14W. W.M.

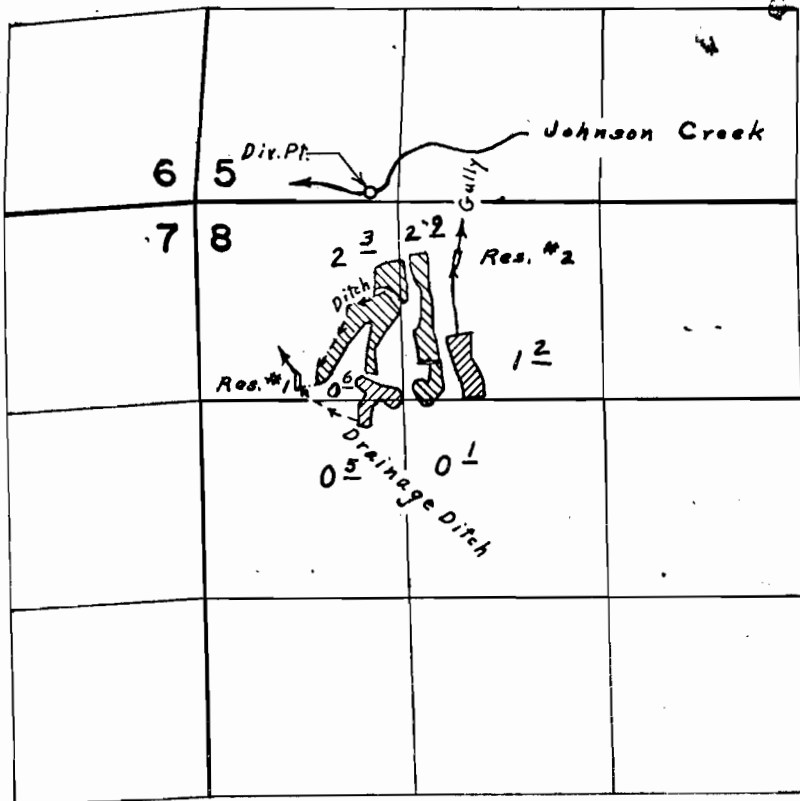

Div. Pts. located: Cr. 30' N. & 1190' E.; Res. #1, 1240' S. & 650' E.; Res. #2, 390' S. & 1760' E., all from N.W. Cor. Sec. 8

FINAL PROOF SURVEY UNDER

R-45812 R-5432
Application No. 45813 Permit No. 34186

IN NAME OF

ELMER A. & GRACE E. GANT

Surveyed April 20, 1972, by L. E. Gould