


T.30S.R.5W.W.M.

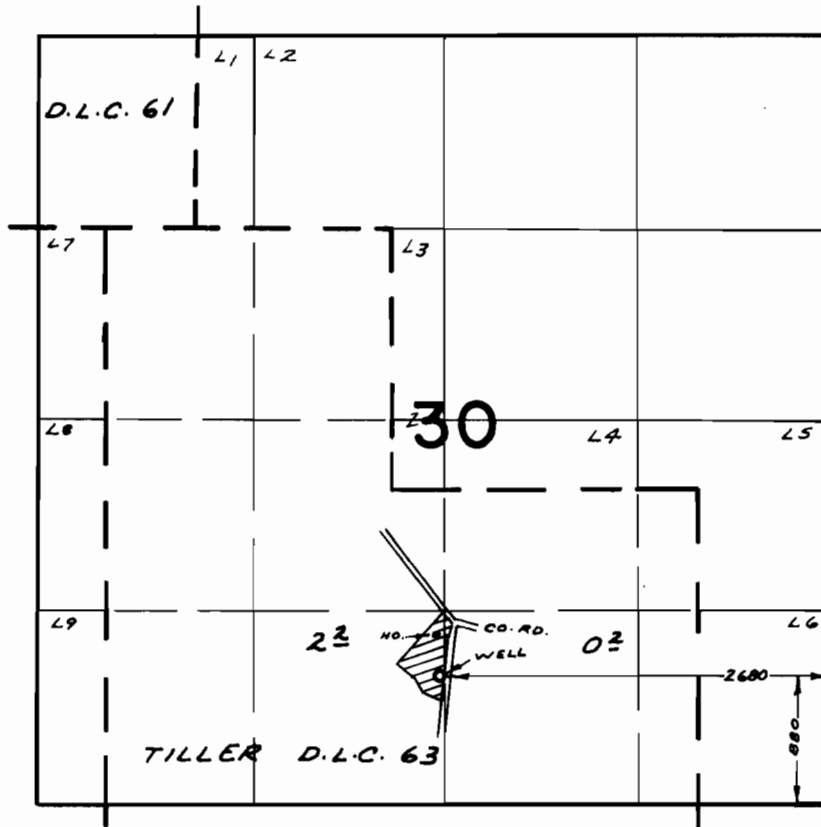

FINAL PROOF SURVEY UNDER

Application No. G-3398 Permit No. G-3188
IN NAME OF

DONALD EARL OLSEN

Surveyed MAY 12, 1972, by R. MUCKEN