


T.26S., R.7W., W.M.

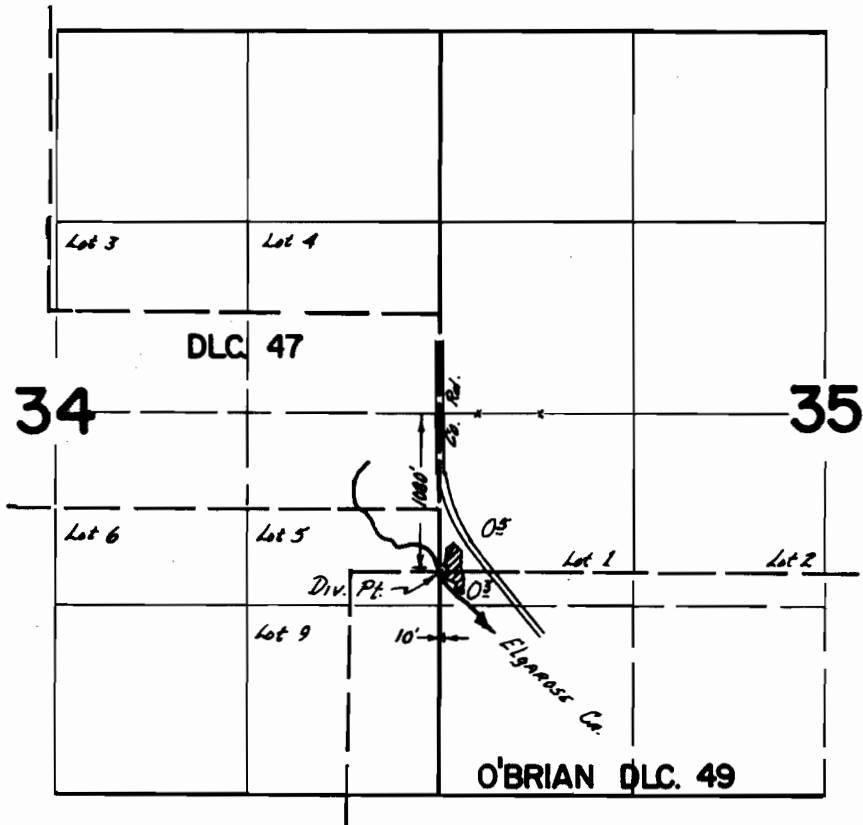

**FINAL PROOF SURVEY**  
UNDER

Application No. 40356 Permit No. 30089  
IN NAME OF

RUSSELL M. BROWN

Surveyed 5 MAY 1972, by D. NORBY