


T. 25 S., R. 7 W., W. M.

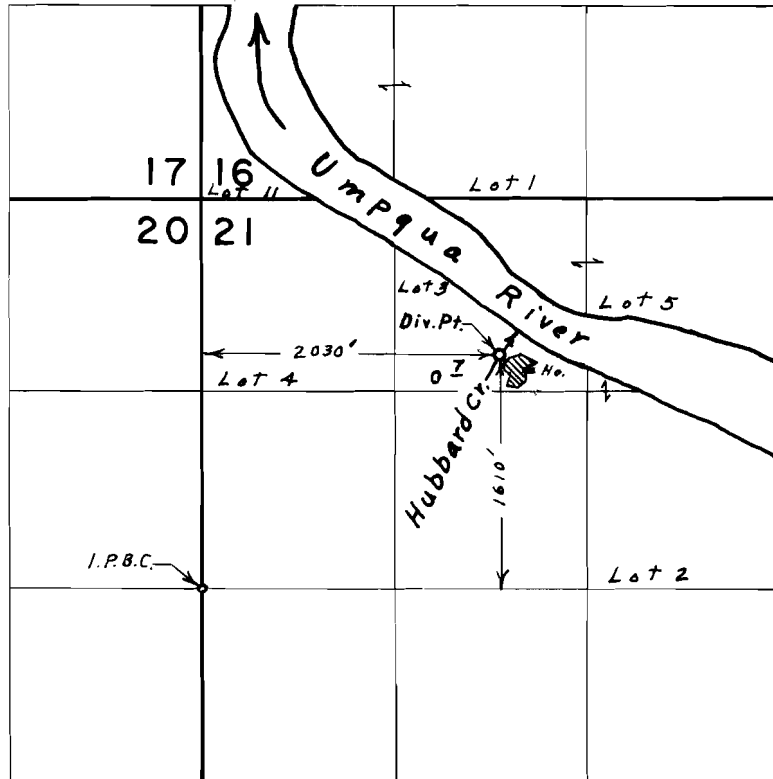

FINAL PROOF SURVEY
UNDER

Application No. 40737 Permit No. 30629
IN NAME OF

ANDRE P. & FERN C. LA PRE

Surveyed May 2, 1972, by L. E. Gould