


# T.27S.R.5W.W.M.

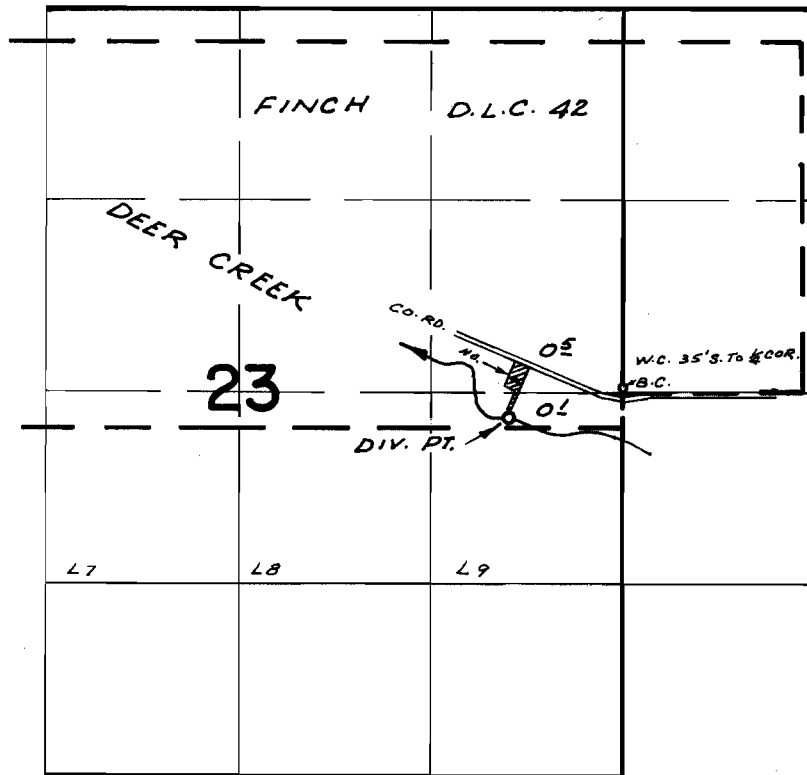

## FINAL PROOF SURVEY UNDER

Application No. 41601 Permit No. 31029  
IN NAME OF

J. V. LA CLAIR

Surveyed MAY 9, 1972, by R. MUCKEN