


T. 25 S., R. 7 W., W.M.

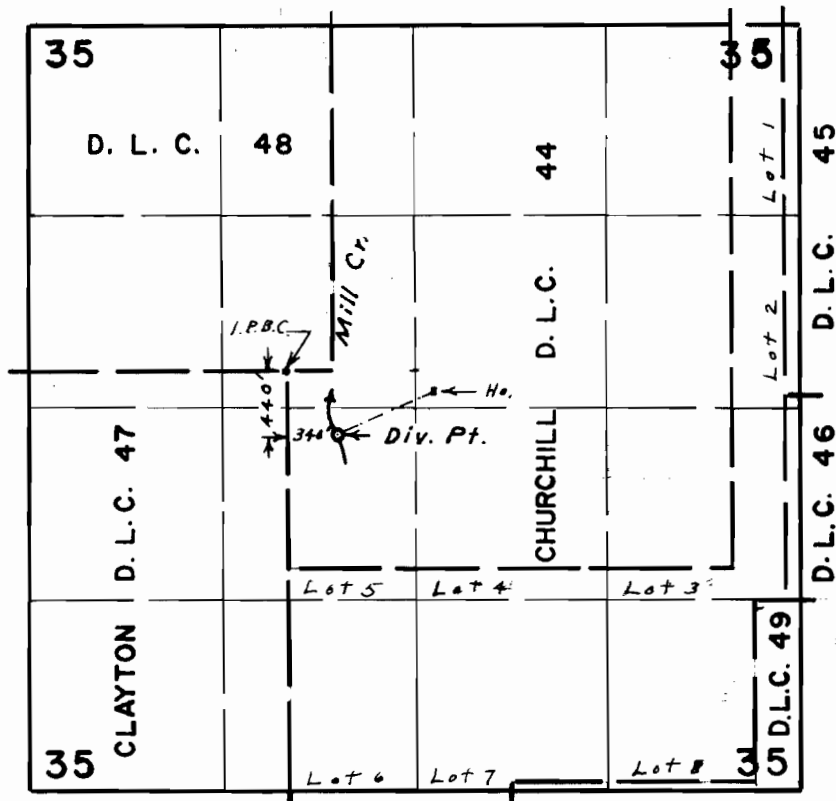

FINAL PROOF SURVEY
UNDER

Application No. 42614 Permit No. 31968
IN NAME OF

LAVERNE D. MURPHY

Surveyed May 2, 1972, by L. E. Gould