


T.26S.R.2W.W.M.

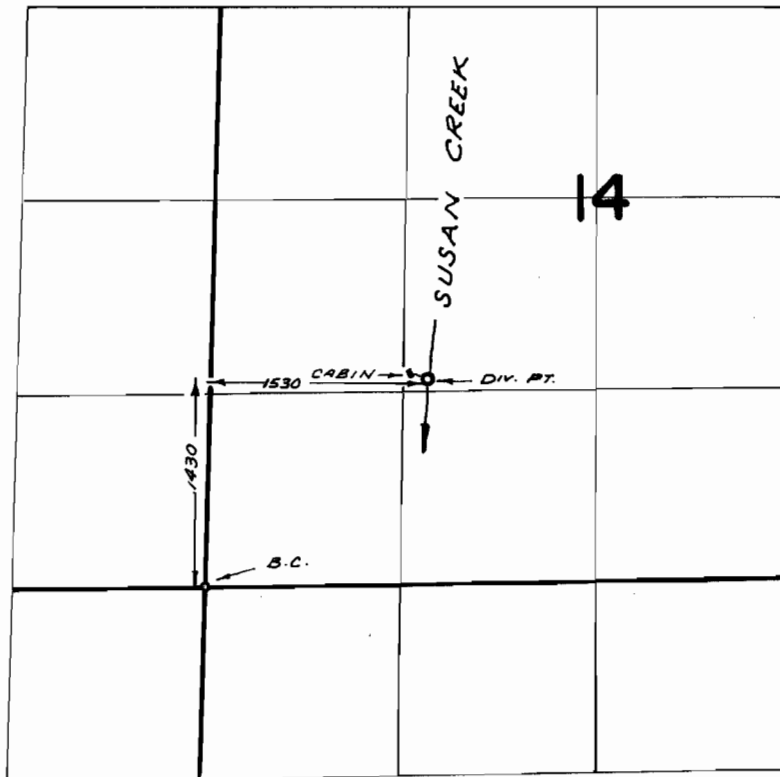

FINAL PROOF SURVEY
UNDER

Application No. 42972 Permit No. 32104
IN NAME OF

EDWIN W. ROE

Surveyed MAY 3, 1972, by R. MUCKEN