


# T.25 S., R.7 W. W.M.

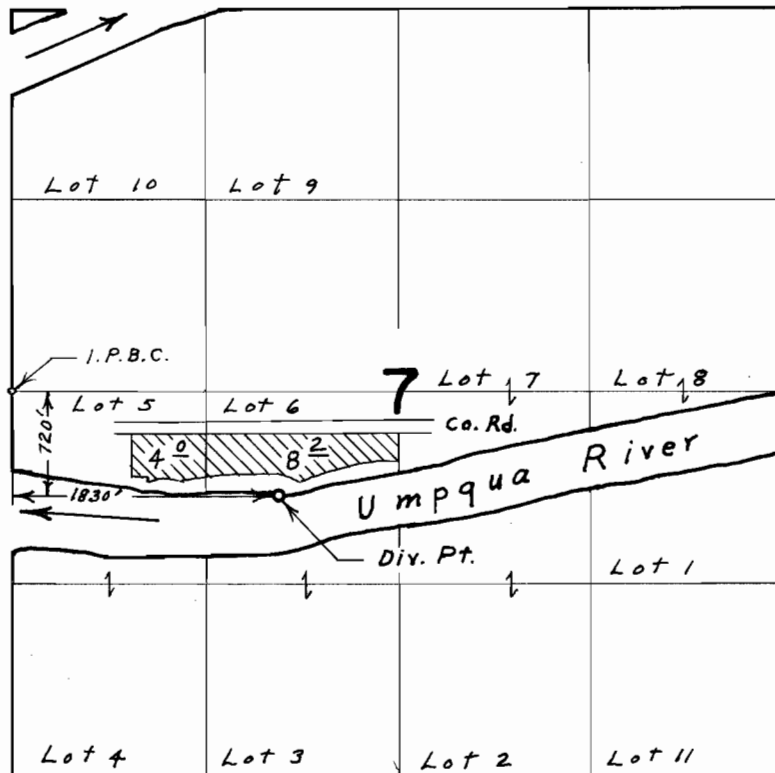

## FINAL PROOF SURVEY UNDER

Application No. 42991 Permit No. 32121  
IN NAME OF  
**CHARLES L. & DOROTHY M. O'MALLEY**  
Surveyed May 1, 1972, by L. E. Gould