


T. 30 S., R. 6 W., W. M.

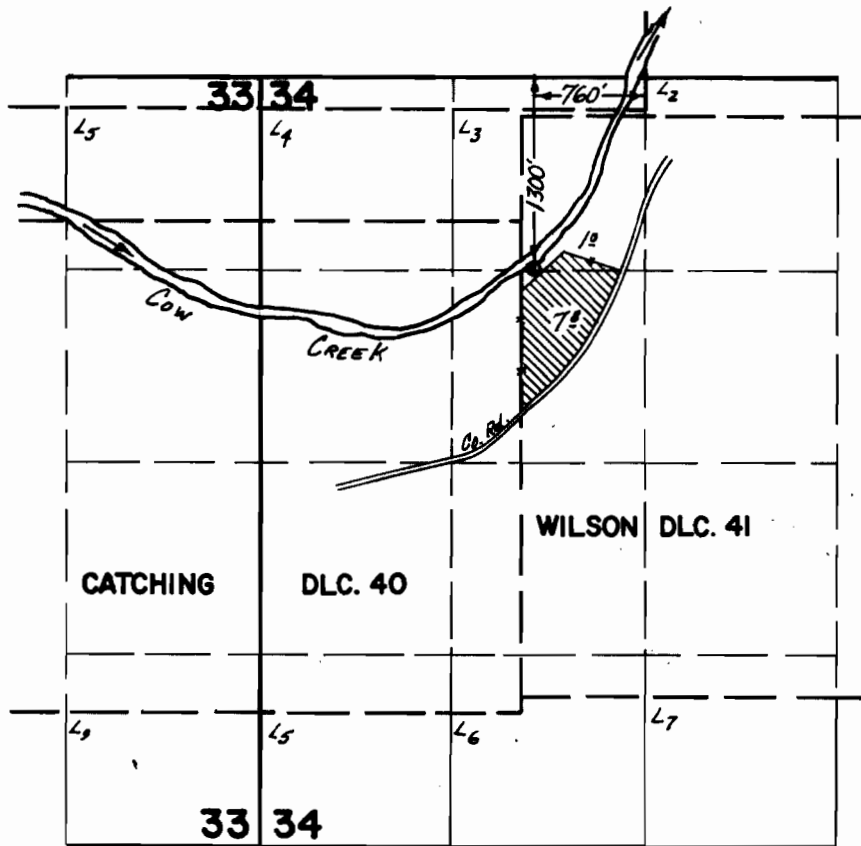

FINAL PROOF SURVEY
UNDER

Application No. 43377 Permit No. 32419
IN NAME OF

LUCILLE A. STREMCHA

Surveyed Sept. 13 1972, by D. NORBY