


T.25 S., R.6 W., W.M.

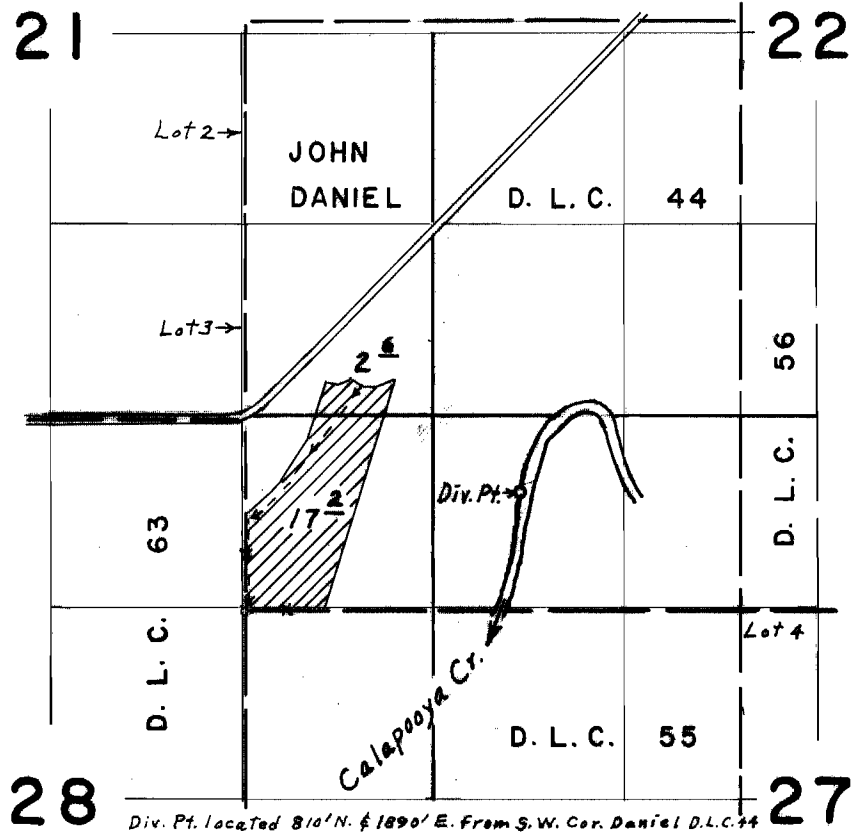

FINAL PROOF SURVEY
UNDER

Application No. 43595 Permit No. 32598
IN NAME OF
HAROLD CROUCH

Surveyed May 11, 1972, by L. E. Gould