


# T.26S.R.3W.W.M.

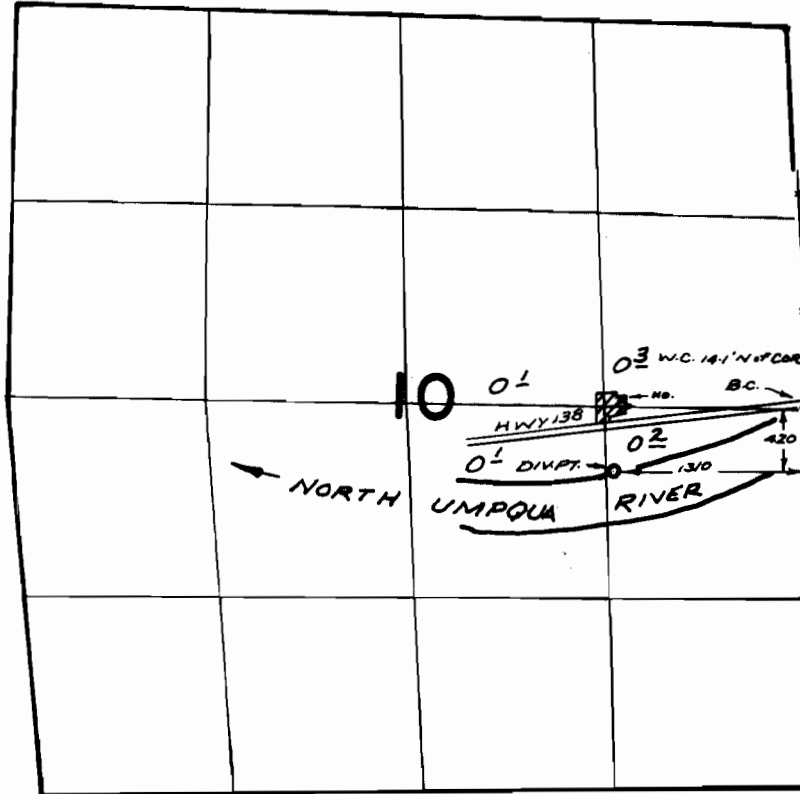

## FINAL PROOF SURVEY UNDER

Application No. 44121 Permit No. 32955  
IN NAME OF

JOHN A. BARNEY

Surveyed MAY 4, 1972, by R. MUCKEN  
APR. 16, 1969 W. RUPPERT