


T.29S., R.6W., W.M.

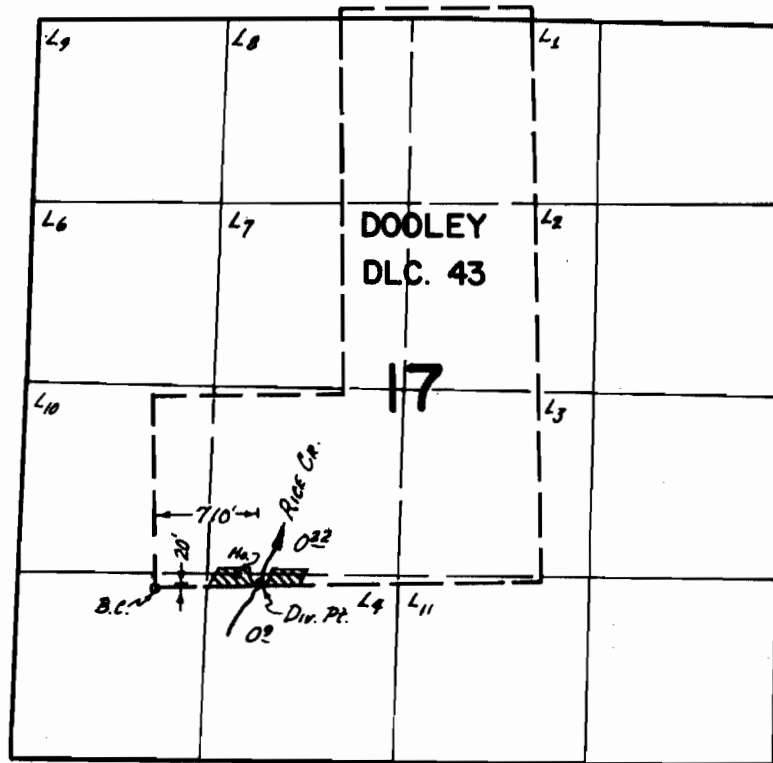

3000000

**FINAL PROOF SURVEY**  
UNDER

Ac No. 30

Application No. 44155 Permit No. 32974  
IN NAME OF

RUTH ELIZABETH GARBE

Surveyed 11 MAY 1972, by D. NORBY

*Handwritten mark*