


T.26S.R.3W.W.M.

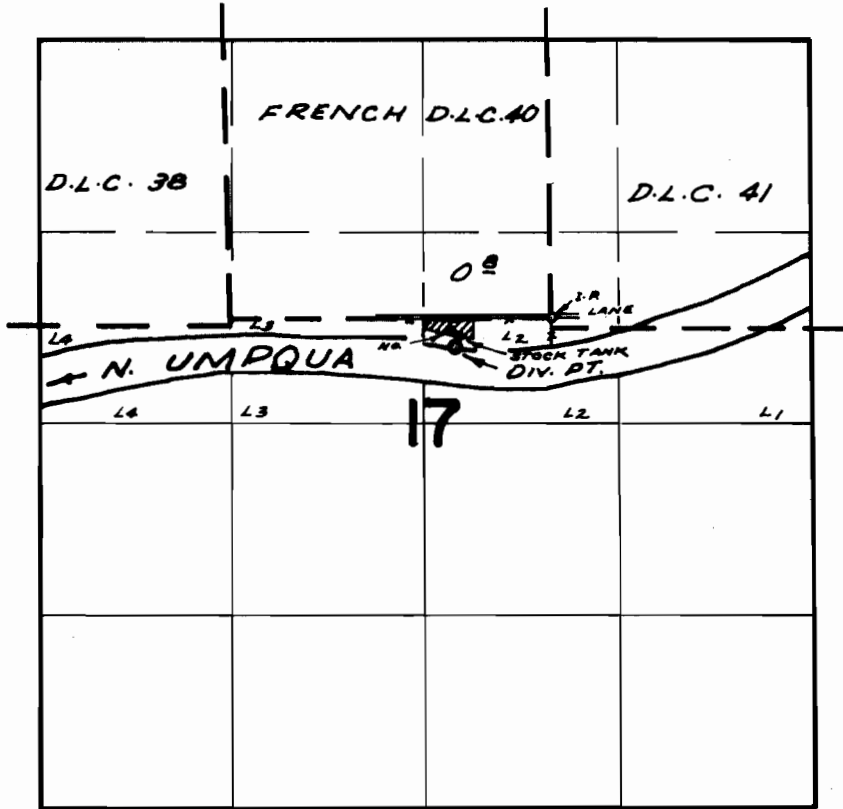

DIV. PT. LOC: 200'S. & 660'E. FROM S.E. COR.
FRENCH D.L.C. 40

FINAL PROOF SURVEY UNDER

Application No. 14260 Permit No. 33066
IN NAME OF

RAYMOND O. & GERTRUDE C. BALLOU

Surveyed MAY 4, 1972, by R. MUCKEN