


T. 30S., R. 4W., W.M.

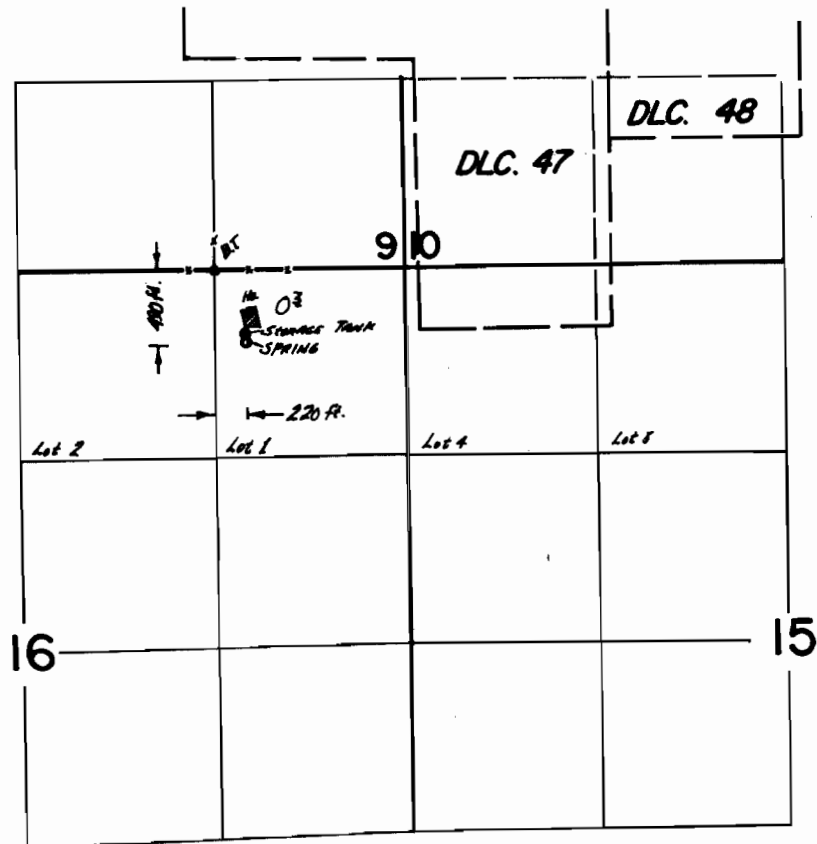

FINAL PROOF SURVEY
UNDER

Application No. 46111 Permit No. 34450
IN NAME OF

ELMER E. MILLER

Surveyed 14 Sept. 1972, by D. NORBY