


T.27S., R.5&6W., W.M.

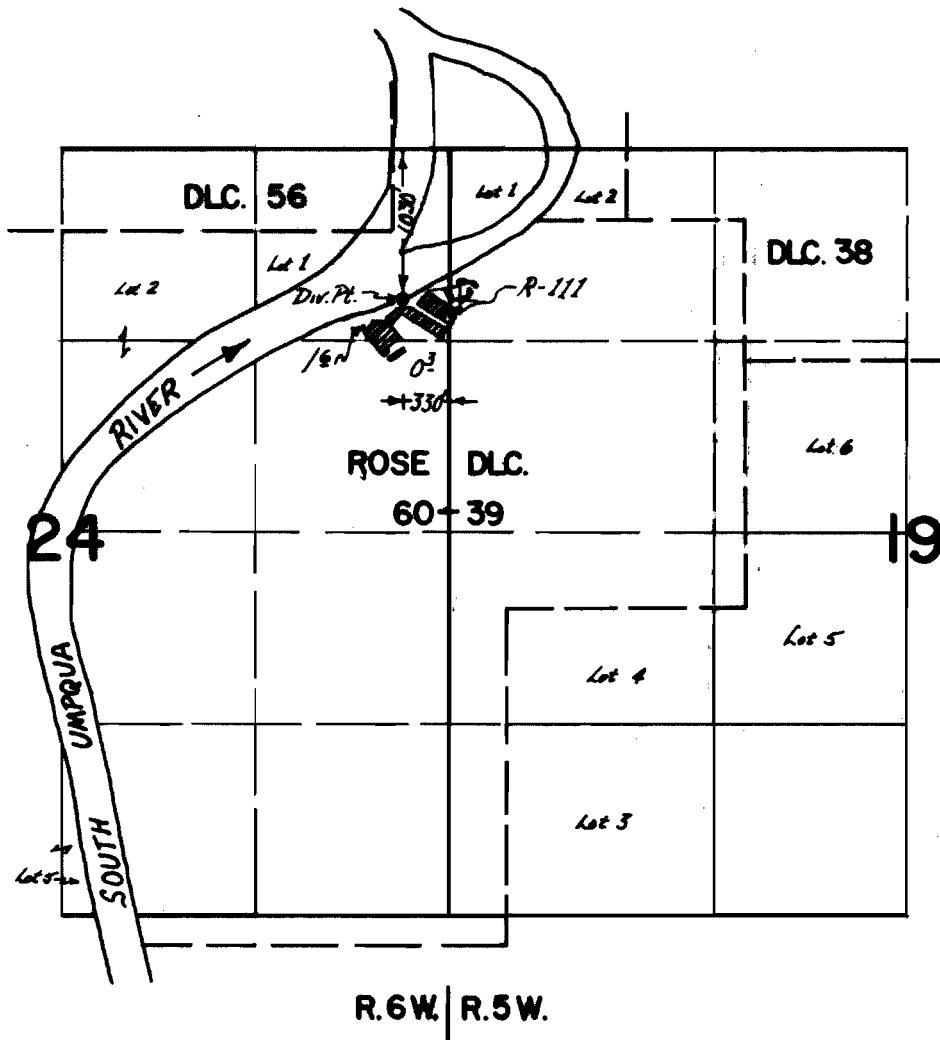

FINAL PROOF SURVEY
UNDER

Application No. 46205 Permit No. 34522
IN NAME OF

CITY OF ROSEBURG

Surveyed 1 May 1972, by D. NORBY