


T.25S., R.6W., W.M.

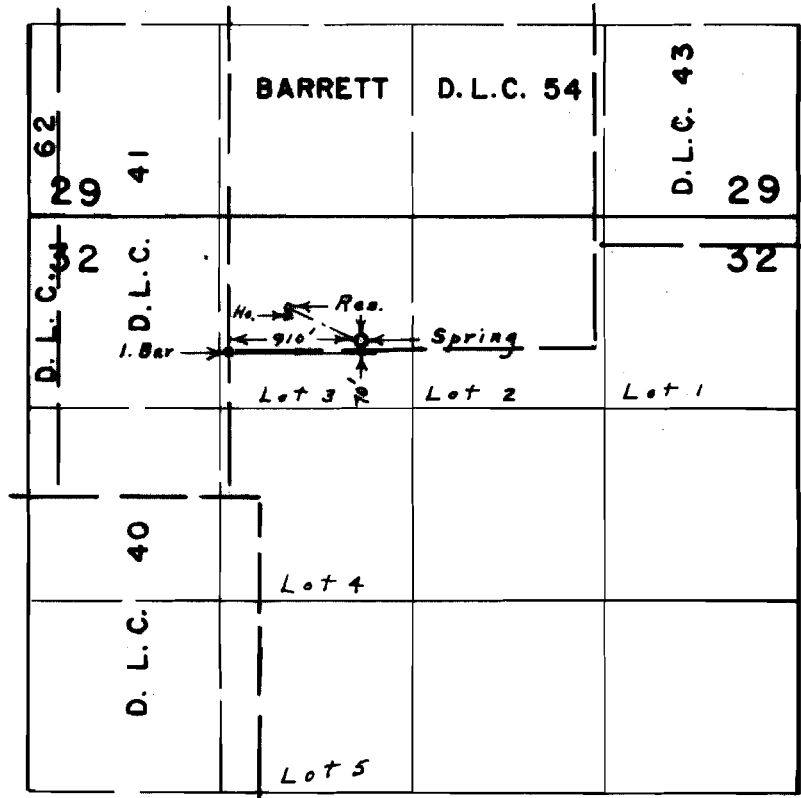

FINAL PROOF SURVEY UNDER

Application No. 46323. Permit No. 34611
IN NAME OF

LESTER RICHARDSON

Surveyed May 12, 1972, by L. E. Gould.