


SECTION

TOWNSHIP 265, RANGE 46, W. M.

North

West

East

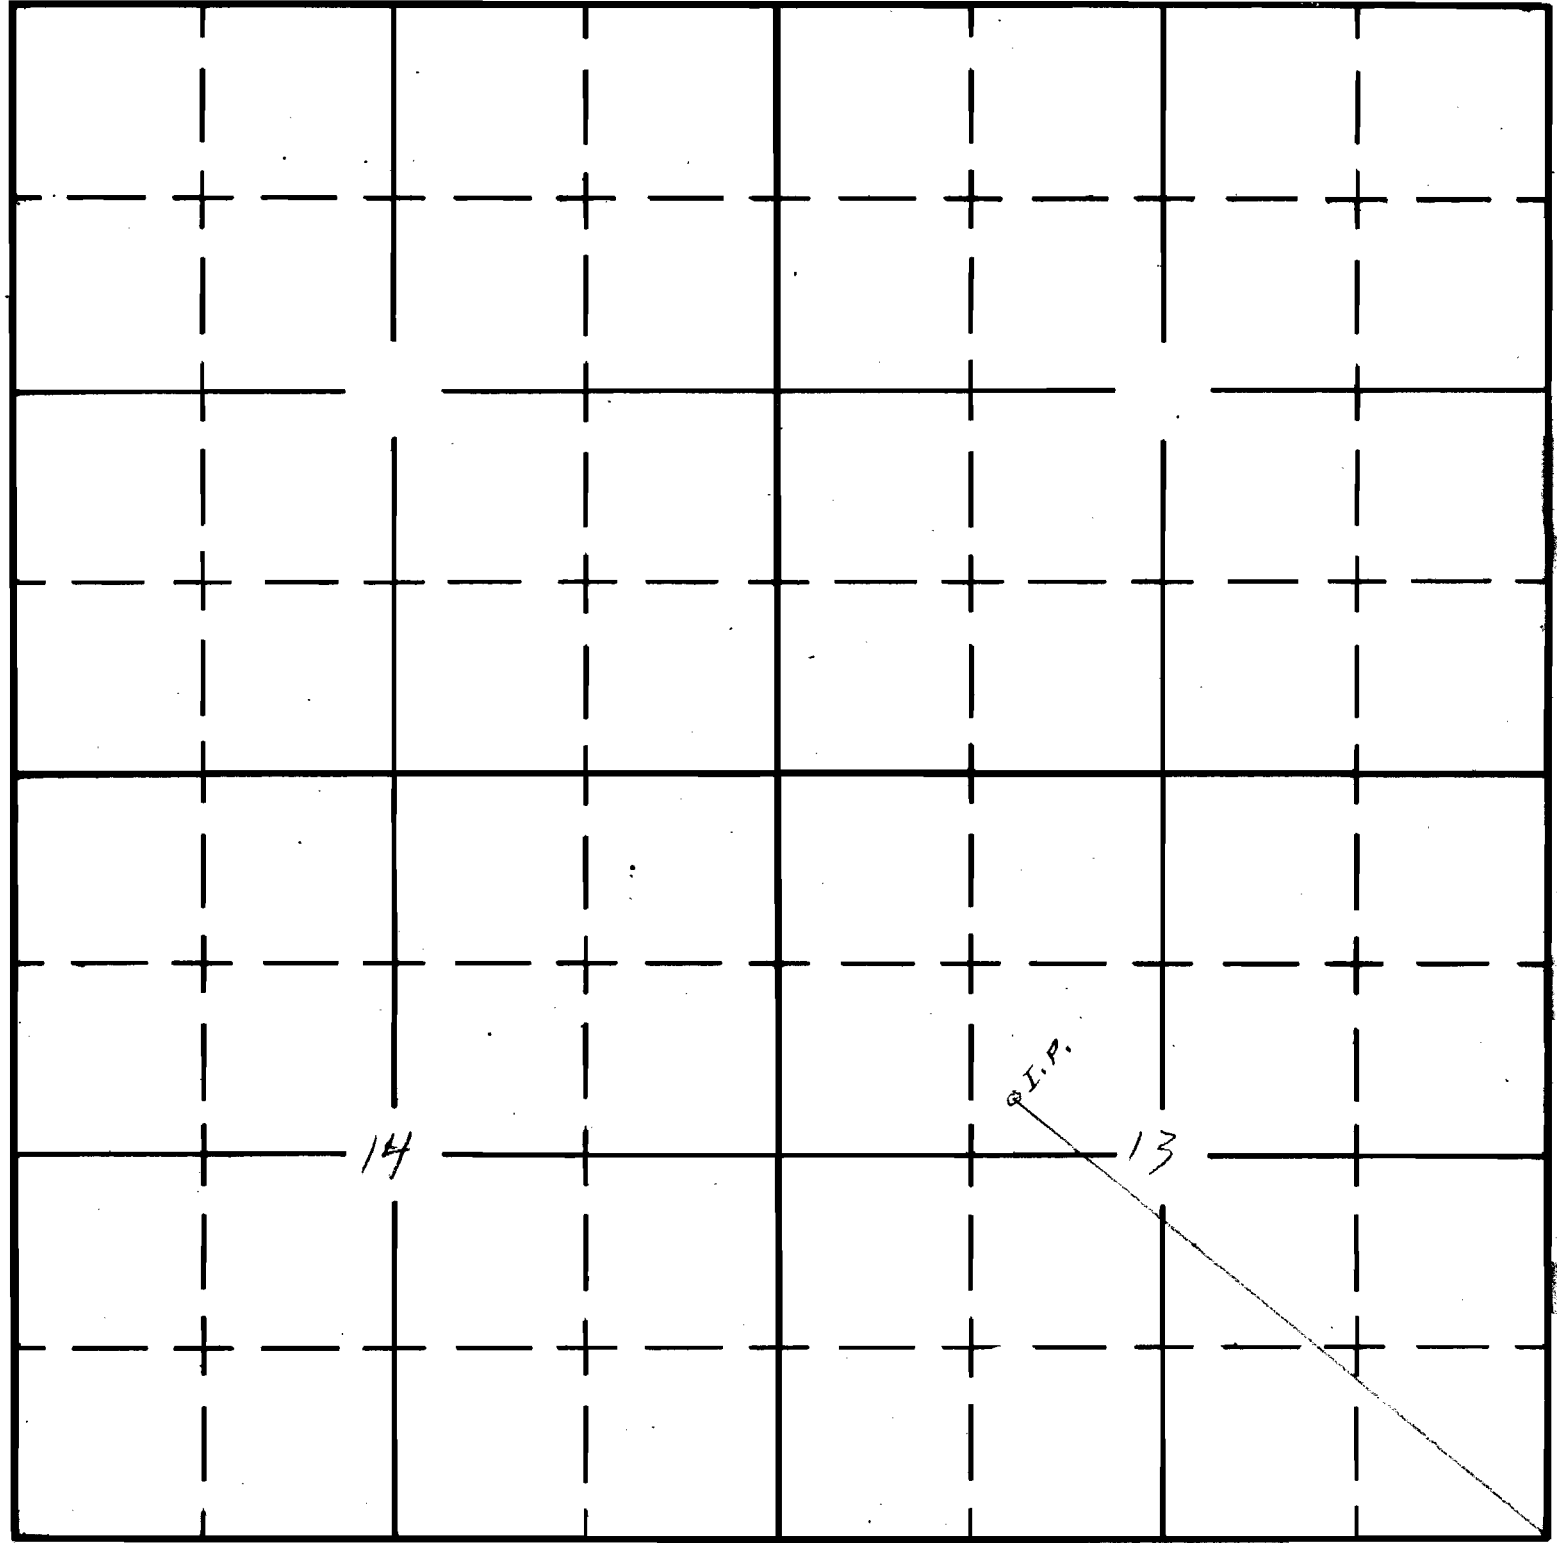

14

13

I.P.

South