


T. 30 S., R. 5 W., W.M.

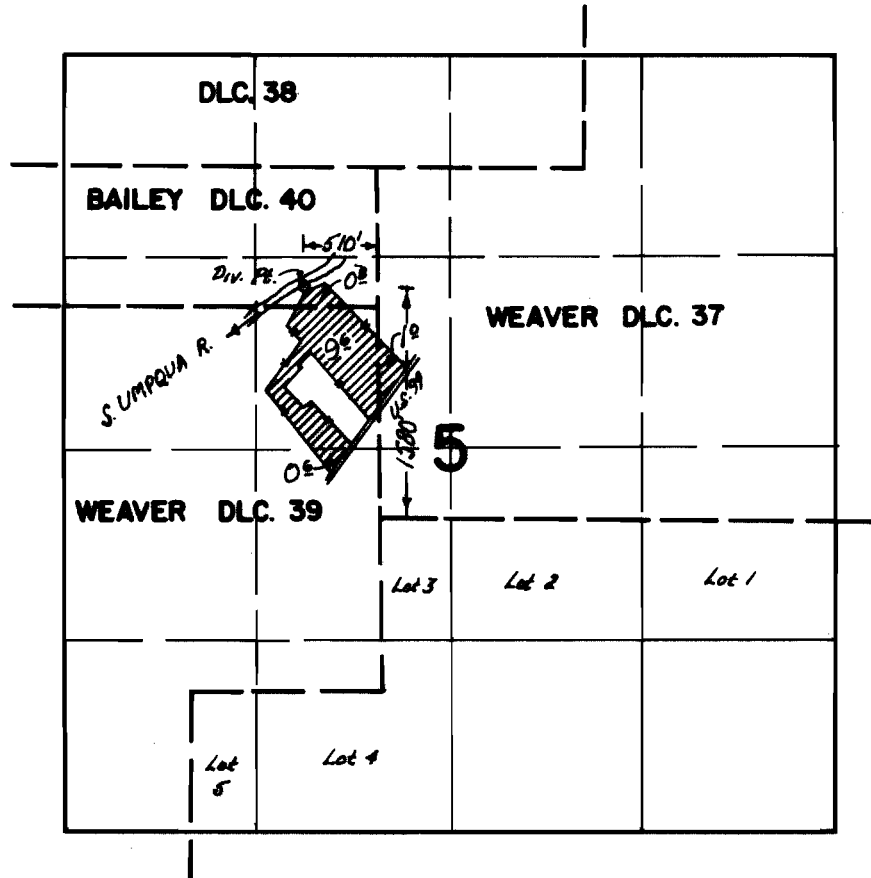

FINAL PROOF SURVEY UNDER

Application No. 46558 Permit No. 34782
IN NAME OF

THOMAS H. IRELAND

Surveyed 11 Sept. 1972, by D. NORBY