


T.32S.,R.6W.,W.M.

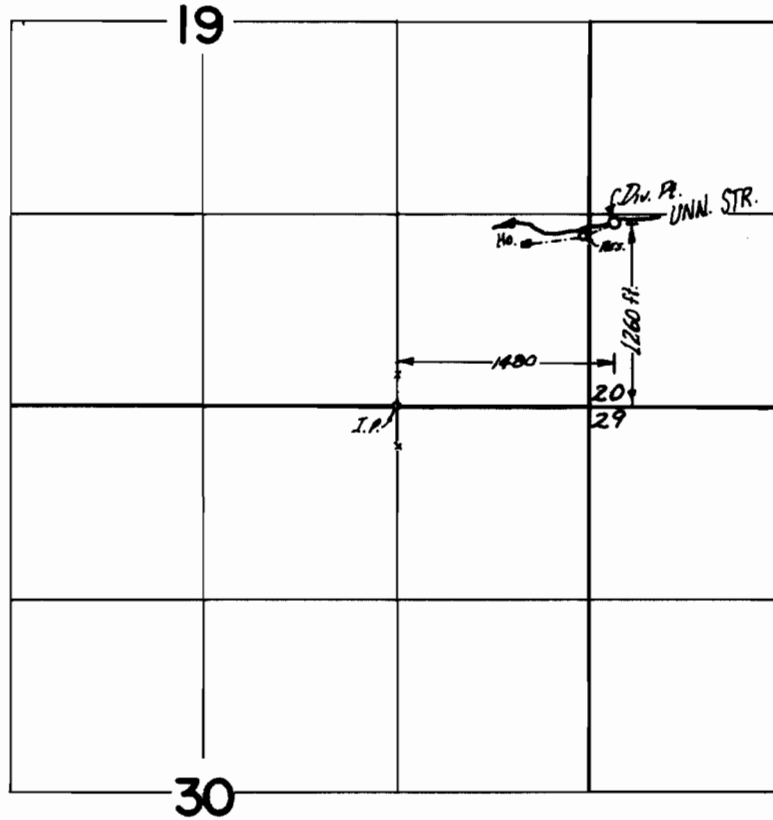

FINAL PROOF SURVEY
UNDER

Application No. 46584 Permit No. 34813
IN NAME OF

LYMAN E. WARREN

Surveyed 23 Aug. 1972, by L.E. GOULD