


T.29S., R.7W., W.M.

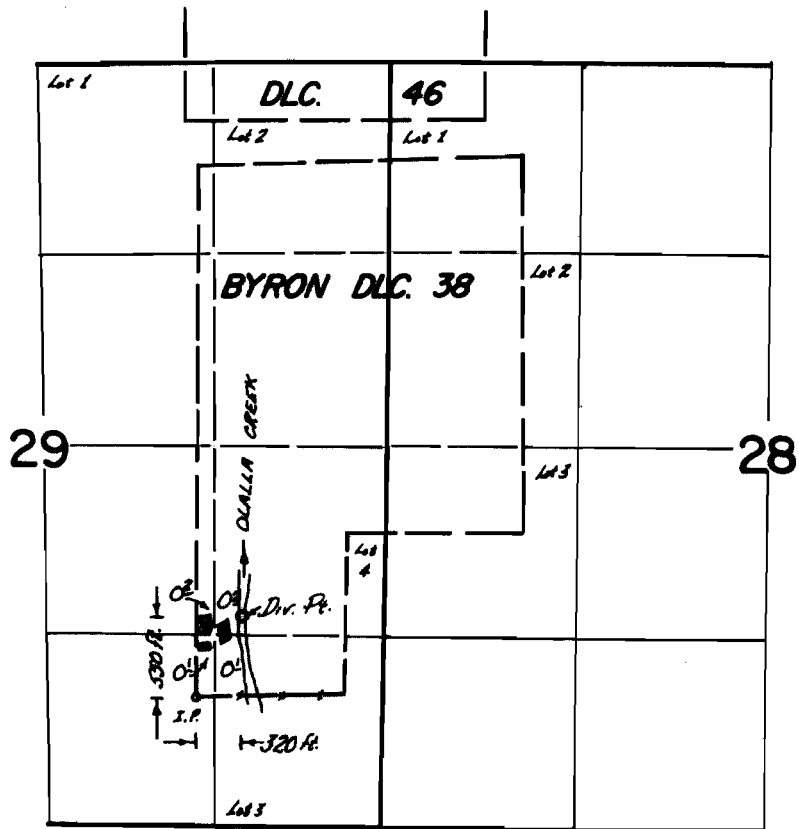

FINAL PROOF SURVEY
UNDER

Application No. 46689 Permit No. 34876
IN NAME OF

J. A. WINTER

Surveyed 9 May 1972, by D. NORBY