


T.26S., R.6W., W. M.

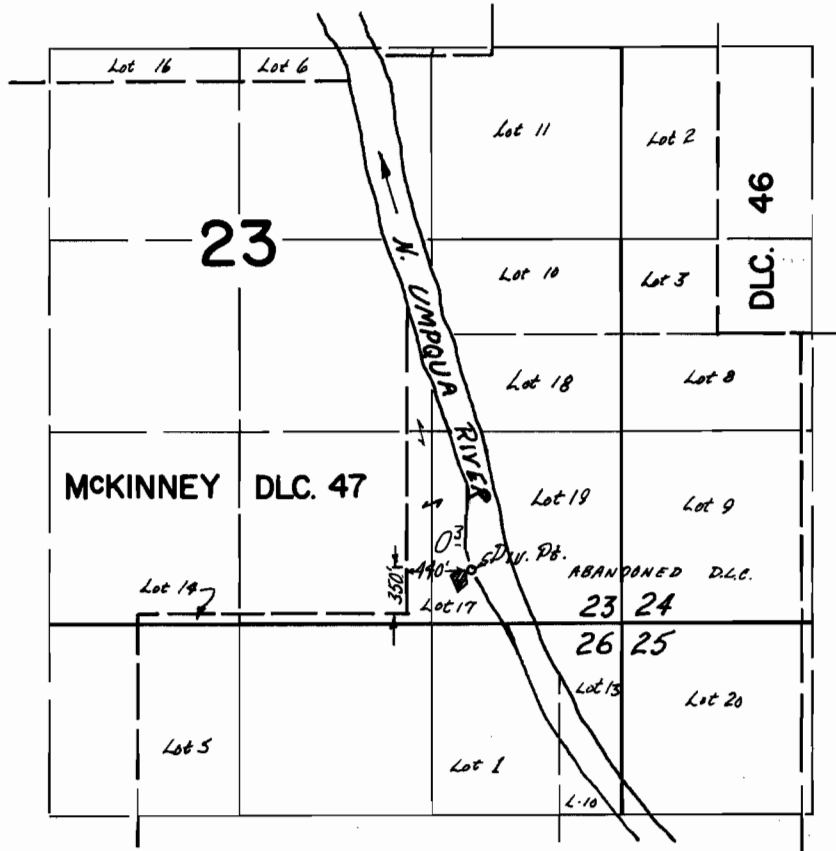

FINAL PROOF SURVEY UNDER

Application No. 47618 Permit No. 35641
IN NAME OF

FRANCIS M. SHEPHERD

Surveyed 2 MAY 1972 by D. NORBY