


T.32S., R.5W., W.M.

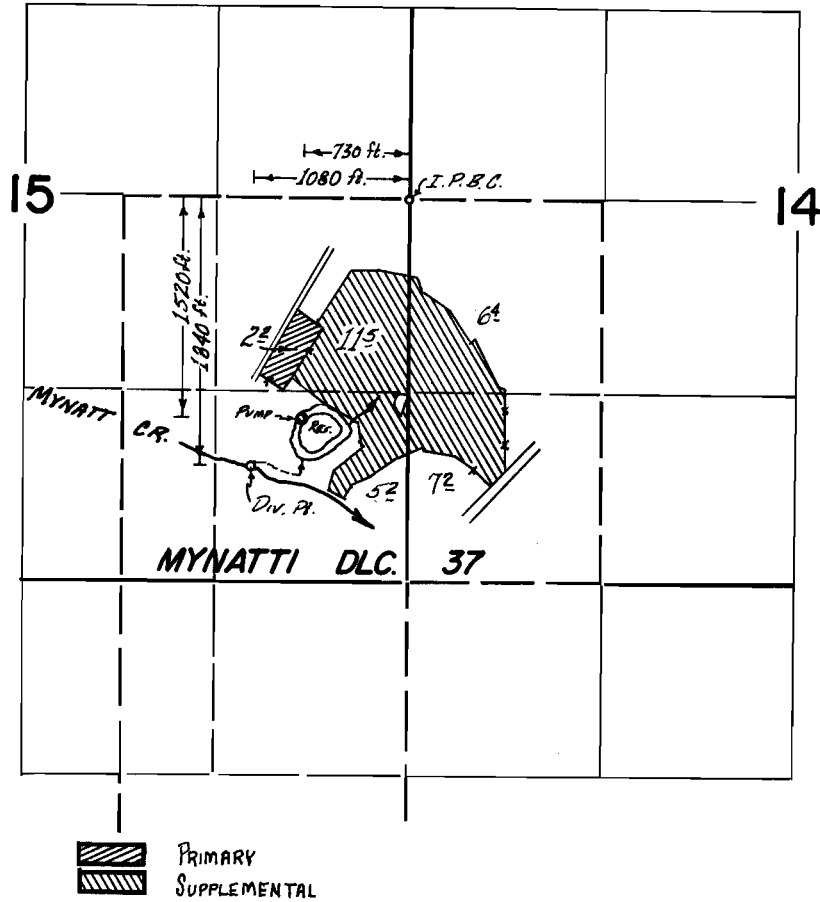

FINAL PROOF SURVEY
UNDER

R-47413 R-5714
Application No. 47912 Permit No. 35605
IN NAME OF
LOUIS BRADY

Surveyed 23 Aug. 1972, by L. E. GOULD